

YALO.

MISSISSIPPI BOARD OF WATER COMMISSIONERS

CODED

E 16
4-12-63

WATER WELL DRILLERS LOG

Zalobusha

Date: *April 12*, 19 *63*, Driller: *James P. Lime* County *Ponchartraine*
(Name)

	Description & Color of Materials Sand, Clay, Red Clay, Shell, etc.	Thick- ness Feet	Depth Feet
(1) Owner of Land: <i>Mrs. H.C. Nerly</i> (Name) <i>Dillataha</i> (Address)	<i>Clay</i>	<i>0</i>	<i>15</i>
(2) Location: $\frac{1}{4}$, $\frac{1}{4}$, Sec. <i>32 25 4</i> T. N. R. E. <i>1/2</i> miles <i>north</i> , of <i>Dillataha</i> (distance) (direction) (Nearest Town)	<i>Sand & Clay</i> <i>P - Ground</i> <i>Grnd & gravel</i> <i>Wetland Sand</i>	<i>15</i> <i>30</i> <i>50</i> <i>70</i>	<i>30</i> <i>50</i> <i>70</i> <i>92</i>
(3) Topography: <i>Hilly</i> (Hilly) (Flat) (Level)			
(4) Purpose of Well: <i>Domestic</i> (Domestic Irrigation Municipal, Industrial, Other)			


Information upon completion of well:

- (1) Diameter *2* inches.
- (2) Total Depth *92* feet.
- (3) Water Level *60* feet below top of ground.
- (4) Cased to *85*, Size *2"*
- (5) Screen: Size *1/4*, Length *6'*
- (6) Were any formations sealed against pollution?
_____ yes, _____ no.

If YES depth of formation _____

Why _____

Drillers Remarks: _____

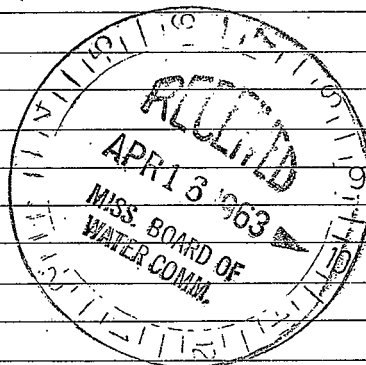

(Use Back Side)

Well No.

