

Yalobusha
E 19
11-5-69

MISSISSIPPI
BOARD OF WATER COMMISSIONERS
416 North State Street
Jackson, Mississippi 39201

CODED

WATER WELL DRILLERS LOG

November 5, 1969 Layne-Central Company Yalobusha
date well completed firm name county well located

LANDOWNER:

Town of Oakland

Oakland, Mississippi

(mailing address)

description of formations encountered

from

to

WELL LOCATION:

sec. 10 T 25 N R. 4 E
5 W

_____ miles of _____
(distance) (direction) (nearest town)

WELL PURPOSE: Municipal
(home, irrigation, municipal, industrial)

WELL COMPLETION DATA:

- (1) diameter (inches) 8"
- (2) total depth (feet) 446' 2"
- (3) static water level (feet) 152' below top of ground.
- (4) casing steel 405'
(material) (depth)
8" If telescope see back.
(size)
- (5) screen 31' 10" 408'
(length) (depth to top)
6" wire wrapped s. s.
(size) (material)
- (6) pump 15 180
(HP) (yield gpm)
electric
(type power) q
- (7) electric log no
(yes or no)

(organization running log)

(8) how well bottom plugged _____

DRILLERS REMARKS:

Clay	45	45
Clay with stks of sand	56	11
Clay	60	4
Coarse sand	77	17
Coarse sand & pea gravel	102	25
Clay	113	16
Sand & stks of clay	135	17
Fine sand with stks blue sandy clay	155	20
Coarse sand	194	39
Black sandy shale	280	86
Sandy shale	328	48
Clay	395	67
Sand	412	17
Sand stks shale	438	26
Clay	446	8


DEC - 4 1969

MISS. BD. OF
WATER COMMISSIONERS

2

If well telescopes please sketch and show depths.

GROUND LEVEL

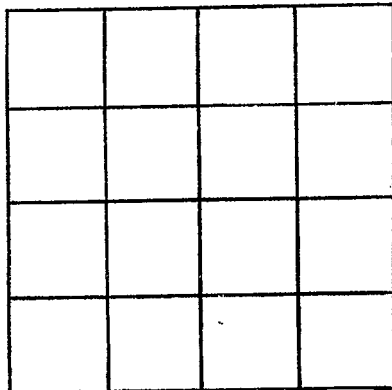

SECTION _____

Please indicate well location X.

ADDITIONAL INFORMATION

If more than one screen, show locations of each on sketch.