

15 G

Change from 64

Yalobusha
E 20
11-6-68

MISSISSIPPI
BOARD OF WATER COMMISSIONER
416 North State Street
Jackson, Mississippi 39201

CODED
CODED
CODED
CODED

WATER WELL DRILLERS LOG

Nov 6 1968 Peterson Well Drilling Co. Yalobusha
date well completed firm name county well located

LANDOWNER: Ben Whitwell
Pt 2
Coffeeville, Miss
(mailing address)

description of formations encountered	depth	
	from	to
Red Clay	0	20
White Clay + sand	20	40
White clay sand	40	80
Blue Clay	80	260
Blue Clay + gravel	260	340

WELL LOCATION:
sec. 14 T. 25 N. R. 4 E
5 miles N.E. of Coffeeville
(distance) (direction) (nearest town)

WELL PURPOSE: Home
(home, irrigation, municipal, industrial)

WELL COMPLETION DATA:

(1) diameter (inches) 2"

(2) total depth (feet) 340

(3) static water level (feet) 60 below top of ground.

(4) casing plastic, 240 (material) (depth)
2" (size) If telescope see back.

(5) screen (length) (depth to top)
(size) (material)

(6) pump 1 (HP) 5 (yield gpm)
110 (type power)

(7) electric log 40 (yes or no)
(organization running log)

(8) how well bottom plugged Open Bottom


DRILLERS REMARKS: Plastic Water Well

L-30 1968

MISS. BD. OF WATER COMMISSIONER

If well telescopes please sketch and show depths.

GROUND LEVEL

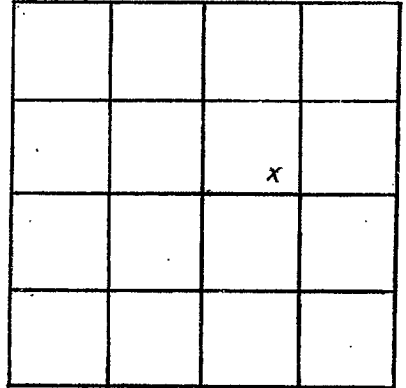

SECTION 17

Please indicate well location X.

ADDITIONAL INFORMATION

If more than one screen,
show locations of each on sketch.