

Yalobusha
E 23
5-2-70

MISSISSIPPI
 BOARD OF WATER COMMISSIONERS
 416 North State Street
 Jackson, Mississippi 39201

CODED

WATER WELL DRILLERS LOG

5. 2 1970 JAMES B. LIPE Yalobusha
 date well completed firm name county well located

LANDOWNER: Mrs Burnes

description of formations encountered	from	to
<u>Clay</u>	<u>0</u>	<u>30</u>
<u>"</u>	<u>30</u>	<u>40</u>
<u>sand</u>	<u>40</u>	<u>60</u>
<u>sand and gravel</u>	<u>60</u>	<u>80</u>
<u>" " "</u>	<u>80</u>	<u>100</u>
<u>sand</u>	<u>100</u>	<u>120</u>
<u>"</u>	<u>120</u>	<u>148</u>

Oakland Miss.
 (mailing address)

WELL LOCATION:
 sec. 8 T. 25 R. 4
1 miles east of Oakland
 (distance) (direction) (nearest town)

WELL PURPOSE: home
 (home, irrigation, municipal, industrial)

WELL COMPLETION DATA:

- (1) diameter (inches) 4
- (2) total depth (feet) 143
- (3) static water level (feet) 90 below above top of ground.
- (4) casing PVC 133
 (material) (depth)
4 if telescope see back.
 (size)
- (5) screen 10 133
 (length) (depth to top)
4 PVC
 (size) (material)
- (6) pump 1/2 10
 (HP) (yield gpm)
Elec.
 (type power)
- (7) electric log no
 (yes or no)
no
 (organization running log)
- (8) how well bottom plugged pvc
plug

CODED


JUL 10 1970

DRILLERS REMARKS:

MISS. BD. OF
 WATER COMMISSIONERS

If well telescopes please sketch and show depths.

GROUND LEVEL

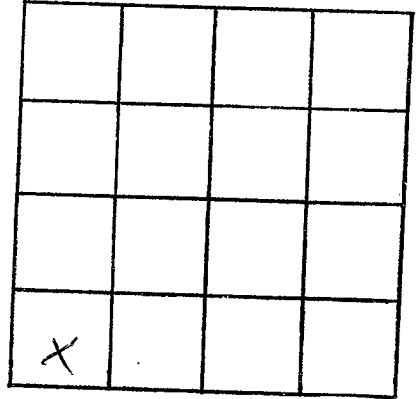

SECTION 8

Please indicate well location X.

ADDITIONAL INFORMATION

Lined area for additional information.

If more than one screen, show locations of each on sketch.