

YALOB.

E 25

2-10-62

WATER WELL DRILLERS LOG

CODED Yalobush #

Date: Feb 10, 1962, Driller: James R. Lipe County: Parola

(Name)

(1) Owner of Land: R.M. ROSS

(Name)

OAKLAND

(Address)

(2) Location: 1/4, 1/4, Sec. 3 T25R4E6

5 miles EAST of OAKLAND

(distance)

(direction)

(Nearest Town)

(3) Topography: Hilly

(Hilly)

(Flat)

(Level)

(4) Purpose of Well: Domestic

(Domestic Irrigation, Municipal, Industrial, Other)

Description & Color of Materials
Sand, Clay, Red Clay, Shell, etc.

Thickness
Feet

Depth
Feet

clay
sand, red
gravel
sand

0 35
35 60
60 90
90 117

Information upon completion of well:



- (1) Diameter 2 inches.
- (2) Total Depth 117 feet.
- (3) Water Level 110 feet below top of ground.
- (4) Cased to 117, Size 2"
- (5) Screen: Size 1 1/4", Length 6'
- (6) Were any formations sealed against pollution?

yes, no.

If YES depth of formation

Why

Drillers Remarks:

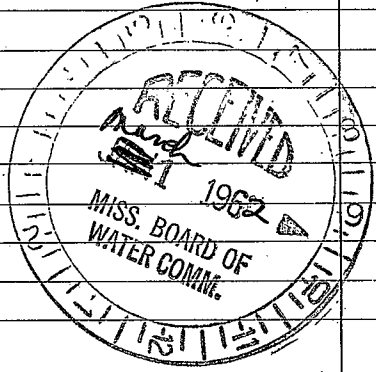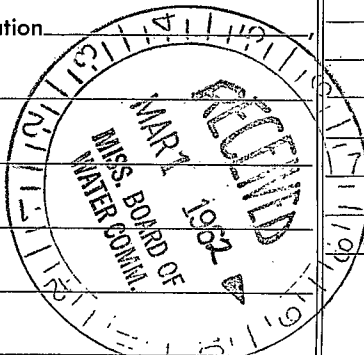

(Use Back Side)

Well No.

