

YALOBUSHA
E 28
1-27-71

MISSISSIPPI
BOARD OF WATER COMMISSIONERS
416 North State Street
Jackson, Mississippi 39201

CODED

WATER WELL DRILLERS LOG

1-27 1971 James R. Lipe Yalobusha
date well completed firm name county well located

LANDOWNER: Mr. F. Lipe
oak land
MISS.
(mailing address)

description of formations encountered	from to	
	feet	feet
Clay	0	20
Sand and gravel	20	40
Sand and clay	40	60
Clay	60	80
Sand	80	104

WELL LOCATION:
sec. 18 T. 25 N. R. 4 E
S W
1 miles South of oakland
(distance) (direction) (nearest town)

WELL PURPOSE: Home
(home, irrigation, municipal, industrial)

WELL COMPLETION DATA:

- (1) diameter (inches) 4"
- (2) total depth (feet) 104
- (3) static water level (feet) 65" below above top of ground.
- (4) casing PVC 94'
(material) (depth)
4" (size) if telescope see back.
- (5) screen 10' 94'
(length) (depth to top)
4" (size) PVC (material)
- (6) pump 3/4 HP 10 (yield gpm)
Elec (type power)
- (7) electric log no (yes or no)
no (organization running log)
- (8) how well bottom plugged PVC
P.V.A.

CODED


MAY 14 1971

DRILLERS REMARKS:

MISS. BD. OF
WATER COM.

If well telescopes please sketch and show depths.

GROUND LEVEL

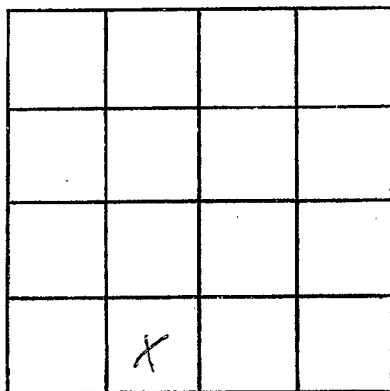

SECTION 18

Please indicate well location X.

ADDITIONAL INFORMATION

If more than one screen, show locations of each on sketch.