

MISSISSIPPI
 BOARD OF WATER COMMISSIONERS
 416 North State Street
 Jackson, Mississippi 39201

CODED

WATER WELL DRILLERS LOG

Yalobusha
 E 35
 8-14-72

8-14 1972 James R. Lipe Yalobusha
 date well completed firm name county well located

LANDOWNER: Ulysses Nesbit
Oakland Miss.
 (mailing address)

WELL LOCATION:
 sec. 20 T. 10N R. 3E
3 miles E of Oakland
 (distance) (direction) (nearest town)

WELL PURPOSE: HOME
 (home, irrigation, municipal, industrial)

- WELL COMPLETION DATA:
- (1) diameter (inches) 4'
 - (2) total depth (feet) 186
 - (3) static water level (feet) 80 below above top of ground.
 - (4) casing PVC, 182'
 (material) (depth)
4 if telescope see back.
 (size)
 - (5) screen 4', 182
 (length) (depth to top)
4 PVC
 (size) (material)
 - (6) pump 3/4 10
 (HP) (yield gpm)
Elec.
 (type power)
 - (7) electric log no
 (yes or no)
non
 (organization running log)
 - (8) how well bottom plugged PVC plug

description of formations encountered	from	to
TOP SOIL	0	20
Sand	20	40
"	40	60
Gravel	60	80
"	80	100
Clay	100	120
"	120	140
"	140	155
Sand and clay	155	160
Sand	160	186

CODED


OCT 28 1972

DRILLERS REMARKS:

MISS. DIV. OF WATER CONTROL

If well telescopes please sketch and show depths.

GROUND LEVEL

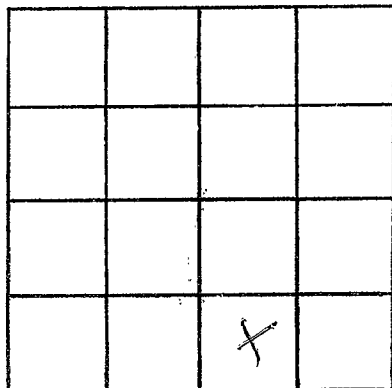

SECTION 20

Please indicate well location X.

ADDITIONAL INFORMATION

If more than one screen,
show locations of each on sketch.