

YALOBUSHA
E 36.
11-17-72

MISSISSIPPI
 BOARD OF WATER COMMISSIONERS
 416 North State Street
 Jackson, Mississippi 39201

CODED

WATER WELL DRILLERS LOG

11-17 1972 JAMES R. LIPE Yalobusha
 date well completed firm name county well located

LANDOWNER: J. R. Horton
Oakland
Miss.
 (mailing address)

description of formations encountered	from	to
	clay	0
sand	20	40
gravel	40	60
''	60	80
''	80	100
sand	100	127

WELL LOCATION:
 sec. 6 T 25 N R 4 E
 S W
1 1/2 miles NW of Oakland
 (distance) (direction) (nearest town)

WELL PURPOSE: Home
 (home, irrigation, municipal, industrial)

WELL COMPLETION DATA: (

- (1) diameter (inches) 4
- (2) total depth (feet) 127
- (3) static water level (feet) 50 below above top of ground.
- (4) casing PVC 117,
 (material) (depth)
4 if telescope see back.
 (size)
- (5) screen 10 117
 (length) (depth to top)
4 PVC
 (size) (material)
- (6) pump 3/4 10
 (HP) (yield gpm)
Elec.
 (type power)
- (7) electric log No
 (yes or no)
No
 (organization running log)
- (8) how well bottom plugged PVC
PIOR


CODED

DEC 20 1972

DRILLERS REMARKS:

If well telescopes please sketch and show depths.

GROUND LEVEL

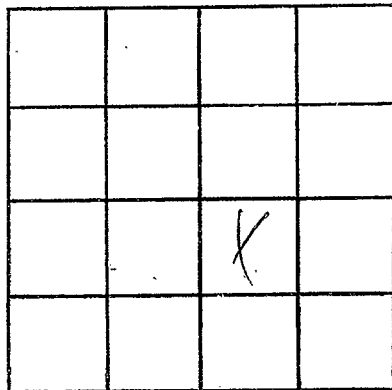

SECTION 6

Please indicate well location X.

ADDITIONAL INFORMATION

If more than one screen, show locations of each on sketch.