

YALOBUSHA  
E 42  
3-7-74

MISSISSIPPI  
BOARD OF WATER COMMISSIONERS  
416 North State Street  
Jackson, Mississippi 39201

CODED

WATER WELL DRILLERS LOG

3-7 date well completed  
1974 LiPe well Co. firm name  
Yalobusha county well located


LANDOWNER:	description of formations encountered	from	to
M. S. Wadlaw			
Tillatoba Miss. (mailing address)	SAND	20	40
	black clay	40	60
	sand and clay	60	80
	cc " "	80	100
	sand	100	120

WELL LOCATION:  
sec. 36 T 25 N R 7 E  
3 miles East of Tillatoba  
(distance) (direction) (nearest town)

WELL PURPOSE:  
(home irrigation, municipal, industrial)

- WELL COMPLETION DATA:
- (1) diameter (inches) 4"
  - (2) total depth (feet) 120
  - (3) static water level (feet) 60 below top of ground.
  - (4) casing PVC 110 (material) (depth)
  - 4 (size) If telescope see back.
  - (5) screen 10 110 (length) (depth to top)
  - 4 PVC (size) (material)
  - (6) pump 3/4 10 (HP) (yield gpm)
  - elec. (type power)
  - (7) electric log no (yes or no)
  - no (organization running log)
  - (8) how well bottom plugged PVC Plug

CODED

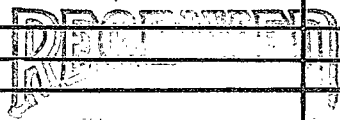


APR 2 1974

DRILLERS REMARKS:

If well telescopes please sketch and show depths.

GROUND LEVEL

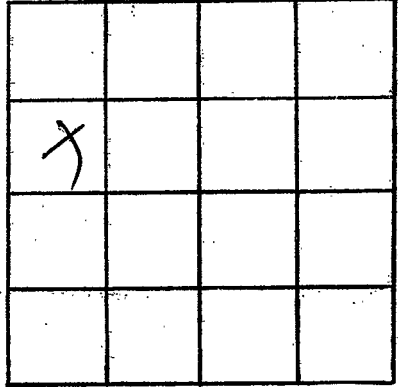

SECTION 35

Please indicate well location X.

ADDITIONAL INFORMATION

If more than one screen, show locations of each on sketch.