

YALOBUSHA
E 45
5-31-74

MISSISSIPPI
 BOARD OF WATER COMMISSIONERS
 416 North State Street
 Jackson, Mississippi 39201

CODED

WATER WELL DRILLERS LOG

50-31 1974 Lipe well Co. Yalobusha
 date well completed firm name county well located

LANDOWNER:
Stanley Gray
Oakland Miss.
 (mailing address)

WELL LOCATION:
 sec. 11 T 25 (N) R 4 (E)
1/2 miles east of Oakland
 (distance) (direction) (nearest town)

WELL PURPOSE:
 (home) Irrigation, municipal, industrial

WELL COMPLETION DATA:

(1) diameter (inches) 12

(2) total depth (feet) 180

(3) static water level (feet) 80 below above top of ground.

(4) casing PVC 170
 (material) (depth)

4 If telescope see back.
 (size)

(5) screen 10 170
 (length) (depth to top)

4 PVC
 (size) (material)

(6) pump 3/4 10
 (HP) (yield gpm)

elec
 (type power)

(7) electric log no
 (yes or no)

no
 (organization running log)

(8) how well bottom plugged PVC
plug

description of formations encountered	from	to
Top soil	0	20
red sand	20	40
" "	40	60
" "	60	80
White clay	80	100
" "	100	120
sand and clay	120	140
sand	140	160
" "	160	180


CODED

RECEIVED
 JUL - 3 1974

DRILLERS REMARKS:

If well telescopes please sketch and show depths.

GROUND LEVEL

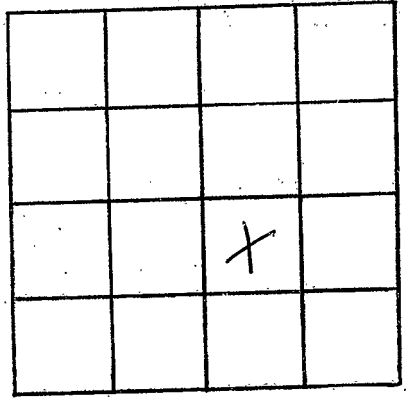

SECTION //

Please indicate well location X:

ADDITIONAL INFORMATION

If more than one screen, show locations of each on sketch.