

Yalobusha

E 48


9-16-74

MISSISSIPPI
 BOARD OF WATER COMMISSIONERS CODED
 416 North State Street
 Jackson, Mississippi 39201

WATER WELL DRILLERS LOG

9-16 1974 LIPE Well Co. Yalobusha
 date well completed firm name county well located

LANDOWNER:	description of formations encountered	from	to
Boyce McCullar Scobey Miss. (mailing address)	TOP Soil red sand Gravel sand ll	0 30 40 60 80	90 70 60 80 100
WELL LOCATION:			
sec. 19 T 25 N R 4 E S W			
5 miles west of Scobey (distance) (direction) (nearest town)			
WELL PURPOSE: (home irrigation, municipal, industrial)			
WELL COMPLETION DATA:			
(1) diameter (inches) 4			
(2) total depth (feet) 100			
(3) static water level (feet) 60 below above top of ground.			
(4) casing PVC 90 (material) (depth)			
4 If telescope see back. (size)			
(5) screen 10 90 (length) (depth to top)			
4 PVC (size) (material)			
(6) pump 3/4 10 (HP) (yield gpm)			
elec. (type power)			
(7) electric log no (yes or no)			
no (organization running log)			
(8) how well bottom plugged PVC PIUG			
DRILLERS REMARKS:			

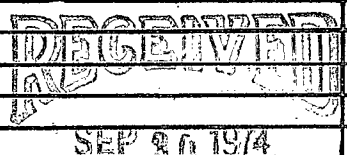

If well telescopes please sketch and show depths.

GROUND LEVEL

X			

SECTION 19

Please indicate well location X.

ADDITIONAL INFORMATION

If more than one screen, show locations of each on sketch.