

YALOBUSHA
E 4A
11-6-74

MISSISSIPPI
BOARD OF WATER COMMISSIONERS
416 North State Street
Jackson, Mississippi 39201

CODED

WATER WELL DRILLERS LOG

11-6 date well completed
LIFE Well Co firm name
Yalobusha county well located

LANDOWNER: LIFE Green
Oakland Miss.

description of formations encountered

from to

TOP SOIL	0	20
sand	20	40
sand	40	80

(mailing address)

WELL LOCATION:

sec. 27 T 25 (N) R 4 (E)
S W
2 miles east of Oakland
(distance) (direction) (nearest town)

WELL PURPOSE:

(home, irrigation, municipal, industrial)

WELL COMPLETION DATA:

CODED

- (1) diameter (inches) 4
- (2) total depth (feet) 80
- (3) static water level (feet) 30 below top of ground.
- (4) casing PVC (material) 70 (depth)
4 (size) If telescope see back.
- (5) screen 10 (length) 70 (depth to top)
4 (size) PVC (material)
- (6) pump 3/4 (HP) 10 (yield gpm)
elec (type power)
- (7) electric log NO (yes or no)
NO (organization running log)
- (8) how well bottom plugged PVC CAP


DRILLERS REMARKS:

DEC 5 1974

MISS. BD. OF WATER COMM.

If well telescopes please sketch and show depths.

GROUND LEVEL

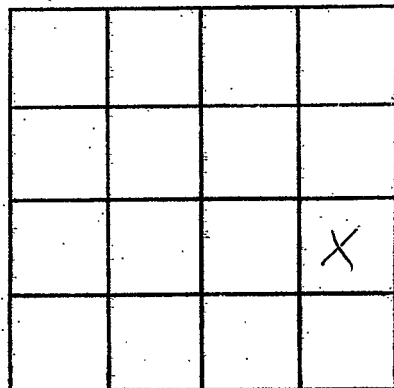

SECTION 27

Please indicate well location X.

ADDITIONAL INFORMATION

If more than one screen,
show locations of each on sketch.