

Yalobusha  
 ESZ  
 5-5-79

MISSISSIPPI  
 BOARD OF WATER COMMISSIONERS  
 416 North State Street  
 Jackson, Mississippi 39201  
 WATER WELL DRILLERS LOG

date well completed 19 firm name \_\_\_\_\_ county well located \_\_\_\_\_

LANDOWNER:	description of formations encountered	from	to
Town of Oakland			
Oakland, MS	Sand and clay	920	940
(mailing address)	Good sand	940	955
	Clay	955	960
WELL LOCATION:	Fine sand and clay	960	980
sec. 18 T 25 <u>N</u> R. 4 <u>E</u>	Sand	980	1000
S W	Fine Sand	1000	1020
_____ miles _____ of _____	Good sand	1020	1040
(distance) (direction) (nearest town)	Fien sand	1040	1050
WELL PURPOSE: (home, irrigation, municipal, industrial)			
WELL COMPLETION DATA:			
(1) diameter (inches) _____			
(2) total depth (feet) _____			
(3) static water level (feet) _____ below above top of ground.			
(4) casing _____ (material) _____ (depth) _____ _____ if telescope see back. (size)			
(5) screen _____ (length) _____ (depth to top) _____ (size) _____ (material) _____			
(6) pump _____ (HP) _____ (yield gpm) _____ (type power) _____			
(7) electric log _____ (yes or no) _____ (organization running log) _____			
(8) how well bottom plugged _____			
DRILLERS REMARKS:			

Miss. Board of Water Comm.


MAY 11 1979

RECEIVED

①

If well telescopes please sketch and show depths.

GROUND LEVEL

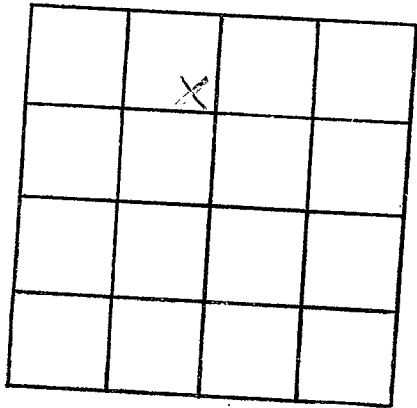

SECTION 18

Please indicate well location X.

ADDITIONAL INFORMATION

If more than one screen, show locations of each on sketch.