

Yalobusha
E 2000
12/9/76

MISSISSIPPI
 BOARD OF WATER COMMISSIONERS
 416 North State Street
 Jackson, Mississippi 39201

WATER WELL DRILLERS LOG

12-9 1976 ELIPE Well Co. Yalobusha
 date well completed firm name county well located

LANDOWNER:
Marvin Reed
Tillatoba MS.
 (mailing address)

description of formations encountered	from	to
<u>TOP soil</u>	<u>0</u>	<u>20</u>
<u>sand</u>	<u>20</u>	<u>40</u>
<u>clay</u>	<u>40</u>	<u>60</u>
<u>sand and clay</u>	<u>60</u>	<u>80</u>
<u>sand</u>	<u>80</u>	<u>125</u>

WELL LOCATION:
 sec. 21 T 25 N R 3 E
3 miles West of Tillatoba
 (distance) (direction) (nearest town)

WELL PURPOSE:
 (home, irrigation, municipal, industrial)

- WELL COMPLETION DATA:
- (1) diameter (inches) 4
 - (2) total depth (feet) 125
 - (3) static water level (feet) 50 below above top of ground.
 - (4) casing PVC 115
 (material) (depth)
 - 4 If telescope see back.
 (size)
 - (5) screen 10 115
 (length) (depth to top)
 - 4 PVC
 (size) (material)
 - (6) pump 3/4 10
 (HP) (yield gpm)
 - elec.
 (type power)
 - (7) electric log non
 (yes or no)
 - non
 (organization running log)
 - (8) how well bottom plugged PVC
cap


DRILLERS REMARKS:

RECEIVED
 DEC 20 1976

MISS. BD. OF WATER COMMISSIONERS

If well telescopes please sketch and show depths.

GROUND LEVEL

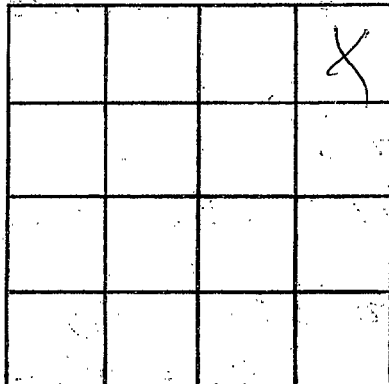

SECTION 21

Please indicate well location X.

ADDITIONAL INFORMATION

If more than one screen, show locations of each on sketch.