

Yalobusha
E 2001

MISSISSIPPI
 BOARD OF WATER COMMISSIONERS
 416 North State Street
 Jackson, Mississippi 39201

WATER WELL DRILLERS LOG

Feb 13 - 82 19 Yalobusha
 date well completed Austin Cain Well Serv firm name Yalobusha
 county well located

LANDOWNER: WR Lamb
Lake Estate
Oakland Ms
 (mailing address)

WELL LOCATION:
 sec. 28 T 30 N R 4 E
5 miles SE of Oakland
 (distance) (direction) (nearest town)

WELL PURPOSE: Home
 (home, irrigation, municipal, industrial)

- WELL COMPLETION DATA:
- (1) diameter (inches) 4
 - (2) total depth (feet) 185
 - (3) static water level (feet) 80 (below/above top of ground)
 - (4) casing Pvc (material), 185 (depth)
 (size) if telescope see back.
 - (5) screen 10 (length), 175 (depth to top)
4" (size), Pvc (material)
 - (6) pump 3/4 (HP), 10 (yield gpm)
Elect (type power)
 - (7) electric log
 (yes or no)

 (organization running log)
 - (8) how well bottom plugged Wash Bottom

description of formations encountered	from	to
<u>Clay</u>	<u>0</u>	<u>20</u>
<u>Sand & Clay</u>	<u>20</u>	<u>61</u>
<u>Rock</u>	<u>61</u>	<u>82</u>
<u>MS Blue Clay</u>	<u>62</u>	<u>120</u>
<u>Rock</u>	<u>120</u>	<u>125</u>
<u>Blue Clay</u>	<u>121</u>	<u>149</u>
<u>Sand</u>	<u>149</u>	<u>185</u>

DEPT. OF NATURAL RESOURCES
 BUREAU OF LAND & WATER RESOURCES


APR 19 1982

RECEIVED

DRILLERS REMARKS:

If well telescopes please sketch and show depths.

GROUND LEVEL

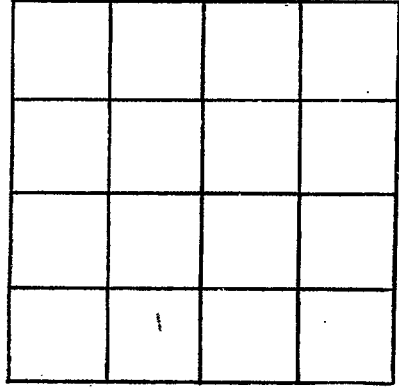

SECTION _____

Please indicate well location X.

ADDITIONAL INFORMATION

If more than one screen, show locations of each on sketch.