

*Yalobusha*

*E 2002*

MISSISSIPPI  
BOARD OF WATER COMMISSIONERS  
416 North State Street  
Jackson, Mississippi 39201

WATER WELL DRILLERS LOG

date well completed

19 *Line Well Supply*  
firm name

*Yalobusha*  
county well located

LANDOWNER: *Fotto Dairy*

description of formations encountered

from to

(mailing address)

WELL LOCATION:

sec. *17* T *25* N R *4* E  
S *3* miles *S* of *0*  
(distance) (direction) (nearest town)

*clay sand* 0 20  
*sand gravel* 20 40  
*white clay* 40 110  
*sand* 110 150

WELL PURPOSE:

(home, irrigation, municipal, industrial)

WELL COMPLETION DATA:

- (1) diameter (inches) *4*
- (2) total depth (feet) *145*
- (3) static water level (feet) *56* below above  
top of ground.
- (4) casing *PVC*, *120*  
(material) (depth)  
(size) if telescope see back.
- (5) screen *25*, *120*  
(length) (depth to top)  
*4*, *PVS*  
(size) (material)
- (6) pump *1/2*, *25*  
(HP) (yield gpm)  
*elec*  
(type power)
- (7) electric log *No*  
(yes or no)

(organization running log)

- (8) how well bottom plugged *PVC*  
*Cap*

DRILLERS REMARKS:


DEPT. OF NATURAL RESOURCES  
BUREAU OF LAND & WATER RESOURCES

SEP 29 1983

RECEIVED

If well telescopes please  
sketch and show depths.

GROUND LEVEL

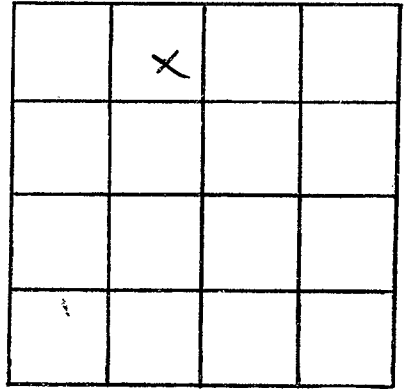

SECTION \_\_\_\_\_

Please indicate well location X.

ADDITIONAL INFORMATION

If more than one screen,  
show locations of each on sketch.