

YALOBUSHA

E 2003

MISSISSIPPI BOARD OF WATER COMMISSIONERS
416 North State Street
Jackson, Mississippi 39201

WATER WELL DRILLERS LOG

July 6 1988
date well completed

Lipell Well Supply
firm name

Yalobusha
county well located

LANDOWNER: Big D Demmon

Oakland MS

description of formations encountered

from to

Clay p. gravel sand
sand 20 58

(mailing address)

WELL LOCATION:

sec. 9 T 25 N S R 4 E W
1 miles E of Oakland
(distance) (direction) (nearest town)

WELL PURPOSE: household use
(home, irrigation, municipal, industrial)

WELL COMPLETION DATA:

- (1) diameter (inches) 4
- (2) total depth (feet) 88
- (3) static water level (feet) 40 below top of ground.
- (4) casing PVC, 40 (material), (depth)
4 (size) if telescope see back.
- (5) screen 8 (length), 80 (depth to top)
4 (size), PVC (material)
- (6) pump 1/2 (HP), 10 (yield gpm)
elec. (type power)
- (7) electric log no (yes or no)

(organization running log)

(8) how well bottom plugged PVC cap


DRILLERS REMARKS:

DEPT. OF NATURAL RESOURCES
BUREAU OF LAND & WATER RESOURCES

JUL 10 1988
RECEIVED

If well telescopes please sketch and show depths.

GROUND LEVEL

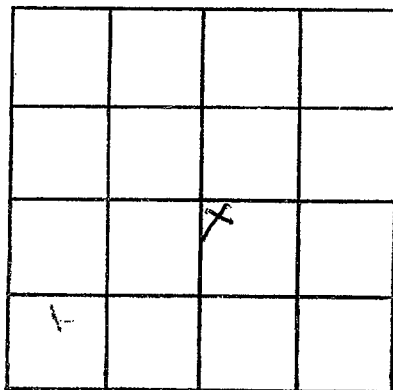

SECTION _____

Please indicate well location X.

ADDITIONAL INFORMATION

If more than one screen,
show locations of each on sketch.