

MISSISSIPPI DEPARTMENT OF NATURAL RESOURCES

Bureau of Land and Water Resources

Southport Mall

P.O. Box 10631

Jackson, Mississippi 39209

WATER WELL DRILLERS LOG

Yalobusha
E 2004

7-9-1985
date well completed

85 LIPE WELL & SUPPLY
firm name

YALOBUSHA
county well located

LANDOWNER: KNOX HARDY
ROUTE 1 BOX 6
OAKLAND MS
(mailing address)

WELL LOCATION:
sec. 5 T. 25 R. 4 E
S. 4 W of OAKLAND
(distance) (direction) (nearest town)

WELL PURPOSE: HOME
(home, irrigation, municipal, industrial)

- WELL COMPLETION DATA:
- (1) diameter (inches) 4
 - (2) total depth (feet) 130
 - (3) static water level (feet) 67 below above top of ground.
 - (4) casing PVC, 120,
(material) (depth)
4 if telescope see back.
(size)
 - (5) screen 10, 120
(length) (depth to top)
4, PVC
(size) (material)
 - (6) pump 3/4, 10
(HP) (yield gpm)
230 10
(type power)
 - (7) electric log NO
(yes or no)
(organization running log)
 - (8) how well bottom plugged CAP

description of formations encountered	from	to
top soil	0	10
sand & gravel	10	25
sand & gravel	25	40
sand & gravel	40	55
clay	55	60
Clay & s Rock	60	70
Clay & sand	70	80
sand	80	90
95 ROCK	90	100
Clay	100	110
Rocklike sand	110	120
sand	120	130


RECEIVED
MAY 19 1986

DRILLERS REMARKS:

Department of Natural Resources
Bureau of Land & Water Resources

If well telescopes please sketch and show depths.

GROUND LEVEL

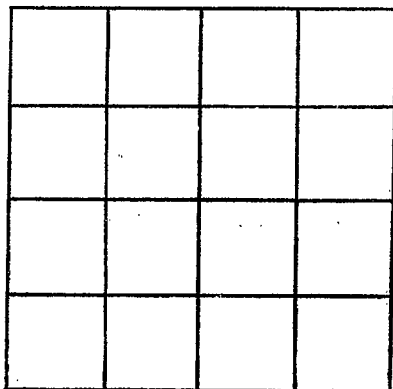

SECTION _____

Please indicate well location X.

ADDITIONAL INFORMATION

If more than one screen,
show locations of each on sketch.