

AL0.
F1
10-23-64

MISSISSIPPI BOARD OF WATER COMMISSIONERS

WATER WELL DRILLERS LOG

CODED
CODED

Date: 10 23, 1964, Driller: J B Cain County: Pontalca
(Name)

(1) Owner of Land: Charles Ingram (Name) Coffville Miss (Address)	Description & Color of Materials Sand, Clay, Red Clay, Shell, etc. Clay Sand	Thick- ness Feet 0 30	Depth Feet 30 90
(2) Location: 1/4, 2 1/4, Sec. 25 5 T R 6 miles E of Coffville (distance) (direction) (Nearest Town)			
(3) Topography: <input checked="" type="checkbox"/> (Hilly) <input type="checkbox"/> (Flat) <input type="checkbox"/> (Level)			
(4) Purpose of Well: Home (Domestic Irrigation Municipal, Industrial, Other)			


Information upon completion of well:

- (1) Diameter 2 inches.
- (2) Total Depth 90 feet.
- (3) Water Level 75 feet below top of ground.
- (4) Cased to 90, Size 2"
- (5) Screen: Size 1 1/4, Length 5 FT
Plastic well
- (6) Were any formations sealed against pollution?
_____ yes, _____ no.

If YES depth of formation _____

Why _____

Drillers Remarks: _____

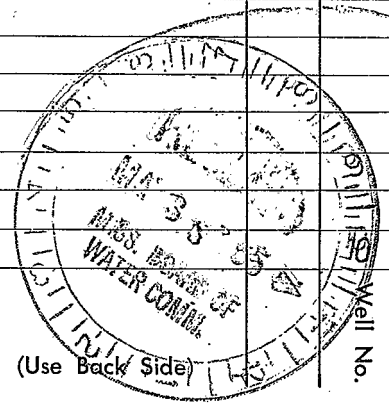

(Use Back Side)

