

YALOBUSHA
F7
5-28-70

MISSISSIPPI
BOARD OF WATER COMMISSIONERS
416 North State Street
Jackson, Mississippi 39201

CODED

WATER WELL DRILLERS LOG *yalobusha*

5-28-70 19 *74 Lipe Well Co.* ~~1970~~
date well completed firm name county well located

LANDOWNER:
Bryant Harlin
Coffeeville Miss.
(mailing address)

| description of formations encountered | from | to |
|---------------------------------------|-----------|-----------|
| <i>Top soil</i> | <i>0</i> | <i>20</i> |
| <i>red clay</i> | <i>20</i> | <i>40</i> |
| <i>" sand</i> | <i>40</i> | <i>60</i> |
| <i>" "</i> | <i>60</i> | <i>80</i> |

WELL LOCATION:
sec. *13* T*25* (N) R. *5* (E)
3 miles *N. W.* of *Coffeeville*
(distance) (direction) (nearest town)

| | | |
|----------------------|------------|------------|
| <i>black clay</i> | <i>80</i> | <i>100</i> |
| <i>sand and clay</i> | <i>100</i> | <i>120</i> |
| <i>white sand</i> | <i>120</i> | <i>134</i> |

WELL PURPOSE:
(home, irrigation, municipal, industrial)

WELL COMPLETION DATA:

(1) diameter (inches) *4*

(2) total depth (feet) *134*

(3) static water level (feet) *60* below above top of ground.

(4) casing *PVC* *124*
(material) (depth)
4 if telescope see back.
(size)

(5) screen *10* *124*
(length) (depth to top)
4 *PVC*
(size) (material)

(6) pump *3/4* *10*
(HP) (yield gpm)
elec.
(type power)

(7) electric log *no*
(yes or no)
no
(organization running log)

(8) how well bottom plugged *PVC plug*

CODED


REGISTERED
JUL - 3 1971

DRILLERS REMARKS:

MISS. BD. OF WATER COMMISSIONERS

If well telescopes please sketch and show depths.

GROUND LEVEL

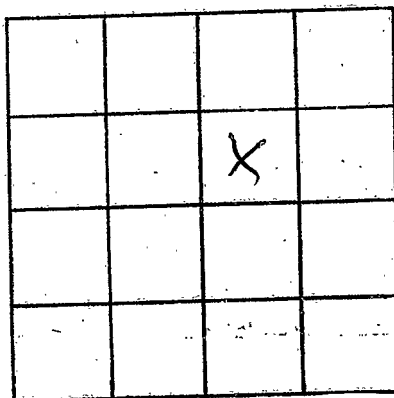

SECTION 13

Please indicate well location X.

ADDITIONAL INFORMATION

If more than one screen, show locations of each on sketch.