

Big Stream

MISSISSIPPI
BOARD OF WATER COMMISSIONERS
416 North State Street
Jackson, Mississippi 39201

CODED

CODED

WATER WELL DRILLERS LOG


YALOBUSHA
F9
9-20-74

Sep 20 1974 HJB Can yalobushe
 date well completed firm name county well located

LANDOWNER: <u>H. E. Evans</u>	description of formations encountered	from	to
(mailing address)			
WELL LOCATION: sec <u>20</u> T <u>25</u> N R <u>5</u> E ¹⁵⁶ <u>10</u> miles <u>N-W</u> of <u>Coffeyville</u> (distance) (direction) (nearest town)	<u>Blue Clay</u>	<u>0</u>	<u>40</u>
WELL PURPOSE: <u>Home</u> (home, irrigation, municipal, industrial)	<u>Sand</u>	<u>40</u>	<u>98</u>
WELL COMPLETION DATA: (1) diameter (inches) <u>4"</u>			
(2) total depth (feet) <u>98</u>			
(3) static water level (feet) <u>40</u> below top of ground. <u>above</u>			
(4) casing <u>Plastic</u> <u>98</u> (material) (depth)			
(5) screen <u>10</u> <u>98</u> (length) (depth to top)			
<u>4"</u> <u>Plastic</u> (size) (material)			
(6) pump <u>1/4</u> <u>10</u> (HP) (yield gpm)			
<u>Elec</u> (type power)			
(7) electric log <u>No</u> (yes or no)			
(8) how well bottom plugged <u>Plug</u>			
DRILLERS REMARKS:			

CODED

CODED

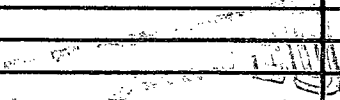


JAN 13 1975

MISS. BD. OF WATER COMMISSIONERS

If well telescopes please sketch and show depths.

GROUND LEVEL

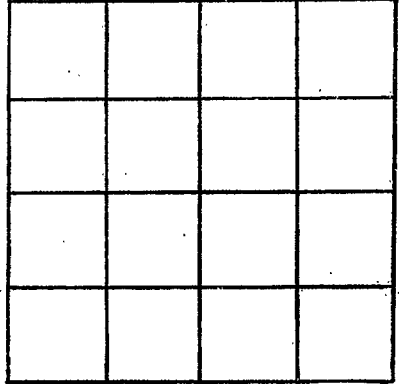

SECTION _____

Please indicate well location X.

ADDITIONAL INFORMATION

If more than one screen, show locations of each on sketch.