

Yalobush
 F 14
 11-10-69

MISSISSIPPI
 BOARD OF WATER COMMISSIONERS
 416 North State Street
 Jackson, Mississippi 39201

CODED
 CODED

WATER WELL DRILLERS LOG

Nov 10 1969 Kathryn Kethiff Yalobush
 date well completed firm name county well located

LANDOWNER Frank Bailey
Lambert, Miss
 (mailing address)

description of formations encountered	from	to
<u>Top Soil</u>	<u>0</u>	<u>90</u>
<u>Sand</u>	<u>90</u>	<u>110</u>
<u>Blue Clay</u>	<u>110</u>	<u>210</u>
<u>Sand</u>	<u>210</u>	<u>231</u>

WELL LOCATION:
 sec 32 T 25 N R 5 E
3/4 miles E Lambert, Miss
 (distance) (direction) (nearest town)

WELL PURPOSE: Home Water
 (home, irrigation, municipal, industrial)

- WELL COMPLETION DATA:
- (1) diameter (inches) 2"
 - (2) total depth (feet) 231
 - (3) static water level (feet) 190 below above top of ground.
 - (4) casing Galv 221
 (material) (depth)
2 if telescope see back:
 (size)
 - (5) screen 10 Standard Steel
 (length) (depth to top)
 (size) (material)
 - (6) pump 3/4 Rod 3 GPM
 (HP) (yield gpm)
Cl
 (type power)
 - (7) electric log no
 (yes or no)
 (organization running log)
 - (8) how well bottom plugged R.V.V.


JAN 30 1970

MISS. BD. OF
 WATER COMMISSIONERS

DRILLERS REMARKS:

If well telescopes please sketch and show depths.

GROUND LEVEL

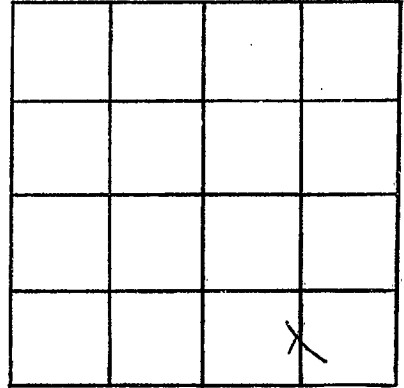

SECTION

32

Please indicate well location X.

ADDITIONAL INFORMATION

If more than one screen, show locations of each on sketch.