

YALOBUSHA
F 16
1-2-75

MISSISSIPPI
BOARD OF WATER COMMISSIONERS
416 North State Street
Jackson, Mississippi 39201

WATER WELL DRILLERS LOG CODED

1-2 date well completed 1975 Lipe Well Co. firm name Yalobusha county well located

LANDOWNER:	description of formations encountered	from	to
Enid Corner	TOP SOIL	0	20
Water Valley Miss.	Clay	20	40
(mailing address)	sand	40	60
	black clay	60	80
	clay and sand	80	100
	white sand	100	120
		120	146

LANDOWNER:

Enid Corner
Water Valley Miss.
(mailing address)

WELL LOCATION:

sec 8 T ~~X~~ N R 5 (E) W
5 miles east of Oakland
(distance) (direction) (nearest town)

WELL PURPOSE:

(home) irrigation, municipal, industrial

WELL COMPLETION DATA:


- (1) diameter (inches) 4"
- (2) total depth (feet) 146
- (3) static water level (feet) 60 below top of ground.
- (4) casing PVC 136 (material) (depth)
- 4" If telescope see back. (size)
- (5) screen 10' 136 (length) (depth to top)
- 4" PVC (size) (material)
- (6) pump 3/4 10 (HP) (yield gpm)
- elec (type power)
- (7) electric log NO (yes or no)
- NO (organization running log)
- (8) how well bottom plugged PVC CAP

DRILLERS REMARKS:

RECEIVED
FEB 5 - 1975
MISS. BD. OF WATER COMMISSIONERS

If well telescopes please sketch and show depths.

GROUND LEVEL

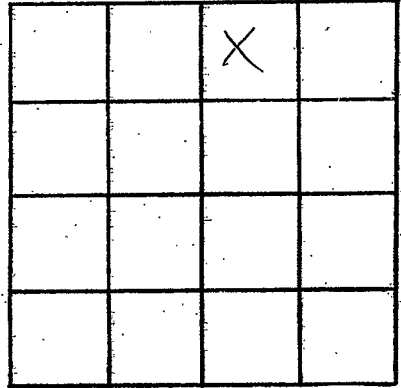

SECTION 8

Please indicate well location X.

ADDITIONAL INFORMATION

If more than one screen, show locations of each on sketch.