

YALO.

MISSISSIPPI BOARD OF WATER COMMISSIONERS

WATER WELL DRILLERS LOG

CODED
CODED

~~6-12-64~~
6-12-64

F-21
Driller: J B Carr

Parola

Date: 6-12, 1964, Driller: J B Carr County Parola

(Name)


(1) Owner of Land: Mike Martin
Opferville Miss
 (Address) 31 256
 (2) Location: 1/4, 3/4, Sec. T R
5 miles W, of Opferville
 (distance) (direction) (Nearest Town)
 (3) Topography: None
 (Hilly) (Flat) (Level)
 (4) Purpose of Well: None
 (Domestic Irrigation
 Municipal, Industrial, Other)

Description & Color of Materials Sand, Clay, Red Clay, Shell, etc.	Thick- ness Feet	Depth Feet
<u>Sand</u>	<u>0</u>	<u>30</u>
<u>Red Clay</u>	<u>30</u>	<u>30</u>
<u>Sand</u>	<u>80</u>	<u>110</u>

Information upon completion of well:

(1) Diameter 2" inches.
 (2) Total Depth 110 feet.
 (3) Water Level 90 feet below top of ground.
 (4) Cased to 110, Size 2"
 (5) Screen: Size 1/4, Length 5 FT
 (6) Were any formations sealed against pollution?
 _____ yes, _____ no.

If YES depth of formation _____
 Why _____
 Drillers Remarks: _____

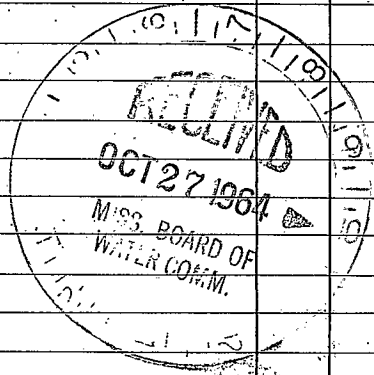

Well No.

(Use Back Side)

Retain this copy for your office files.

