State Well Report				
County: 4 ALObusha	Part 1 – Driller's Log		For Office Use Only:	
County. Of TACOUSAR	Mississippi Department of Environmental Quality		Aquifer:	
Permit #:	Office of Land and Water Resources		Well #:F23	
Driller: PARKS & PARKS	P.O. Box 2307		well#:	
1 7	(601)961- 5210		L. S. Elevation:	
Date drilling completed:		1- 5228 (fax)	F. las #.	
E-log #:				
State Law requires that this report be prepared by the license holder responsible for the work and filed with the				
Department at the above address within 30 days of completion of drilling of the well or borehole. Information on Well Owner Well or Borehole Location				
(Landowner if borehole is not for a water well)				
2 . T	/	Latitude: 34.01,10	" Longitude: 89 ° 47 , 40"	
Owner Name Benny +/			e): Conventional Survey,	
Mailing Address: 2/17 CR 47/ CoFfacuille, NS 38965		USGS quad, Hand-held	GPS, Survey-grade GPS	
LOTTOSVINS	115 20765	NW 14 SE 14 Sec 20	Twn 2SN Rng 600	
City Stat	e Zip Code	Distance Direction Miles	Nearest Town	
Telephone No. (662) 5/4 - 2/3	58	Miles W	or Cottoeville	
Well / Borehole Data				
Date drilling started: 10/2 Date drilling completed: 10/4 Hole depth: 66 Hole diameter: 8				
Location of the source of any surface water used for drilling: Method of dosing and volume of Chlorine used in drilling and development:				
Logs run (circle all applicable No log run Electric Gamma Ray Density Sonic Neutron Other:Name of organization running log(s):				
Purpose of borehole (check one): Water We	ell Geotechnical/Geole	ogical Investigation Ground	Source Heat Pump	
	urvey Other (describe			
If drilling is not related to water well construction, skip the remainder of this block				
Purpose of Well (check one): Home Industrial Public Supply Irrigation Fish Culture Other:				
If a flowing well, method of flow regulation: Valve Other (describe)				
Static Water Level:				
Method of Measurement (circle one) steel tape electric tape air line other:				
Well depth: 66 Well grouted to a depth of 10 feet Type of grout (circle one) Neat Cement Bentonite Mix				
Casing length: 46 feet Casing diameter: 4 inches Type of casing: PUC				
Screen length: 10 feet Screen diameter: 4 inches Type of screen: 10 C				
Screen slot size: , 013 inches Setting depth: From 46 feet to 66 feet				
Type of completion (circle all applicable): Gravel packed Underreamed Telescoped Open hole Natural Development				
Other (describe):				
Top of lap pipe or reduction in casing: feet. If telescoped or more than one screen, describe on next page				


OCT 2 D 2012

The sketch below only required for water wells

<u>Description of formations encountered must be provided for all wells and boreholes, unless specifically exempted by regulations</u>

Description of Formations Encountered	From (depth)	To (depth)
	Ground Level	1
Clay & SAND Clay & SAND	0	15
Clay & SAND	15	37
SAND	37	66
		<u> </u>
	•	

If more than one screen, show location of each on sketch

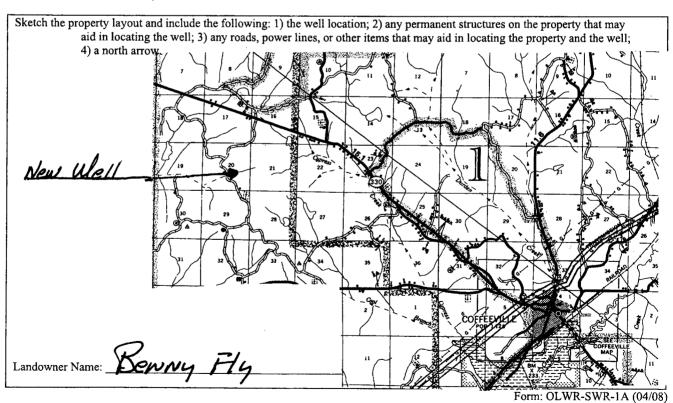

I certify that the well/borehole was drilled, constructed, and completed in accordance with all applicable requirements of the Mississippi Department of Environmental Quality and the Mississippi Department of Health regulations, if applicable, and state laws.

Print Name of Responsible Licensee and License No.

Date

Signature of Licensee

y: OLWF

STATE WELL REPORT

Part 2

Pump Installer's Completion Report
Mississippi Department of Environmental Quality
Office of Land and Water Resources P.O. Box 2309

For Office Use Only:			
Aquifer:			
Well#: F23			
Elevation:			

Date completed: 10(cf/12	Jackson, MS 39225 Well #:		
- 1 ···	(601)961-5210 (601)961-5228 (fax) Elevation:		
Copy information from block on Part 1	(301)/01 220 (331)		
	er well contractor or a licensed pump installer. A copy of Part 1 of the tment at the above address within 30 days of well completion.		
Well Owner Information	Well Location		
Owner Name: Benny Fly	Latitude:Longitude:		
Mailing Address: 2137 CR 47/	Method of Lat/Long (check one): Conventional Survey,		
Coffeeville MS 3856	USGS quad, Hand-held GPS, Survey-grade GPS		
	NW 14 SE 14 Sec 20 T 25NR 6W		
City State Zip Code	Distance Direction Nearest Town		
Telephone No. (662) \$14-2/58	7 Miles W of Cottaeville		
Pump Type	Power Type		
Circle one	Circle one		
Air Lift Jet Submersible	Diesel Engine Gasoline Engine Natural Gas		
Bucket Piston Turbine	Electric Motor Hand Tractor PTO		
Centrifugal Rotary Flowing Well	Windmill Other (specify):		
Other (specify):	Horse Power Rating of Motor:		
Date Pump Installed: 10/4//2	Setting Depth:feet		
Rated Pump Capacity: LO Gallons Per Minu	nte Number of Stages: 12		
Pump Test Data	Method of Measuring Water Level		
- · · · · · · · · · · · · · · · · · · ·	Circle one		
Date Well Tested: 10/4/12	Air Line Electric Measuring Line Steel Tape		
Static Water Level (A):Feet Below Land Surf			
Pumping Water Level (B):Feet Below Land Surfa	ace (specify).		
Drawdown [(B) – (A)]: Feet Below Land Surfa	For flowing well, measured shut in head:feet		
Test Pumping Rate: LO Gallons Per Minu	te Well yieldedGPM with a drawdown of		
Duration of Pump Test (minimum 4 hours):hou	hours of pumping		
I HEREBY CERTIFY that the above statements are true to the best of my knowledge			
Karebyan Frake 0-414 (Nouhun Tanken			
Print Name of Pump Installer and License No. (if applicable)			
	Form: OLWR-SWR-1B (04/08)		