

YALOBUSHA

F

2000

9-8-78

MISSISSIPPI BOARD OF WATER COMMISSIONERS 416 North State Street Jackson, Mississippi 39201

WATER WELL DRILLERS LOG

9-8

19

78

Lipe Well Co.

yalobusha

date well completed

firm name

county well located

LANDOWNER:

Green Gosha Baptist

Church, Coffeeville Ms. (mailing address)

description of formations encountered

from

to

top soil

0

20

red sand

20

40

sand and red clay

40

60

sand and clay

60

120

good white sand

120

180

WELL LOCATION:

sec. 11-25

R 5

4

miles

west of coffeeville

(distance)

(direction)

(nearest town)


WELL PURPOSE: church

(home, irrigation, municipal, industrial)

WELL COMPLETION DATA:

- (1) diameter (inches) 4
(2) total depth (feet) 180
(3) static water level (feet) 90 below above top of ground.
(4) casing pvc (material), 170 (depth)
4 (size) if telescope see back.
(5) screen 10 (length), 170 (depth to top)
4 (size), pvc (material)
(6) pump 3/4 (HP), 10 (yield gpm)
elec. (type power)
(7) electric log no. (yes or no)
no (organization running log)
(8) how well bottom plugged pvc cap

DRILLERS REMARKS:

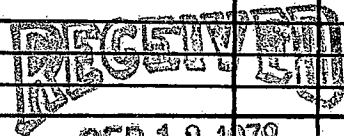

MISS. BD. OF WATER COMM

