

YALOBUSHA

F

12-12-78

MISSISSIPPI BOARD OF WATER COMMISSIONERS 416 North State Street Jackson, Mississippi 39201

WATER WELL DRILLERS LOG

12-12 date well completed

1978 Lipe Well Co, firm name

yalobusha county well located

LANDOWNER:

General Zackery oakland MS, (mailing address)

description of formations encountered

Top soil red sand white sand

from

to

0 20 20 40 40 56

WELL LOCATION:


sec 19 T 22 N R 5 E 6 miles east of oakland (distance) (direction) (nearest town)

WELL PURPOSE:

(home irrigation, municipal, industrial)

WELL COMPLETION DATA:

- (1) diameter (inches) 4
(2) total depth (feet) 56
(3) static water level (feet) 30 below top of ground.
(4) casing PVC 46 (material) (depth) 4 (size) if telescope see back.
(5) screen 18 46 (length) (depth to top) 4 PVC (size) (material)
(6) pump 3/4 8 (HP) (yield gpm) elec (type power)
(7) electric log no (yes or no) no (organization running log)
(8) how well bottom plugged PVC cap

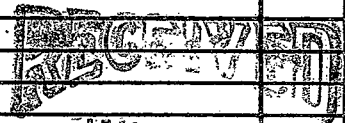


JAN 1 1978

DRILLERS REMARKS:

MISS. BD. OF WA

If well telescopes please sketch and show depths.

GROUND LEVEL

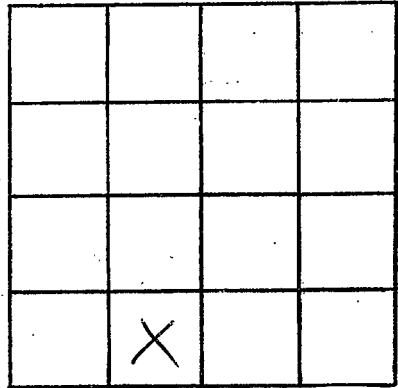

SECTION 19

Please indicate well location X.

ADDITIONAL INFORMATION

If more than one screen, show locations of each on sketch.