

YALOBUSHA
 F 2002
 5-6-81
 56

MISSISSIPPI
 BOARD OF WATER COMMISSIONERS
 416 North State Street
 Jackson, Mississippi 39201

WATER WELL DRILLERS LOG YALOBUSHA
 1981 BIG STREAM CRENADA

date well completed

firm name

county well located

LANDOWNER: FLY
 OKLAND MISS

description of formations encountered

from to

Brn Clay	0	60
SBV CLAY	60	180
SAND	180	200
BLUE CLAY	200	248
SAND STREAKS	248	340
SAND	340	360

(mailing address)

WELL LOCATION:

sec. 29 T 25 N R 5 E
 S W
 6 1/2 miles W of COFFEEVILLE
 (distance) (direction) (nearest town)

WELL PURPOSE: HOME
 (home, irrigation, municipal, industrial)


WELL COMPLETION DATA:

- (1) diameter (inches) 4"
- (2) total depth (feet) 360
- (3) static water level (feet) 130 below top of ground.
- (4) casing PVC 340
 (material) (depth)
 4" if telescope see back.
 (size)
- (5) screen 20 340
 (length) (depth to top)
 4" PVC
 (size) (material)
- (6) pump 3/4 10
 (HP) (yield gpm)
 ELECT
 (type power)
- (7) electric log NO
 (yes or no)

(organization running log)


(8) how well bottom plugged SAND SHARK

DRILLERS REMARKS:

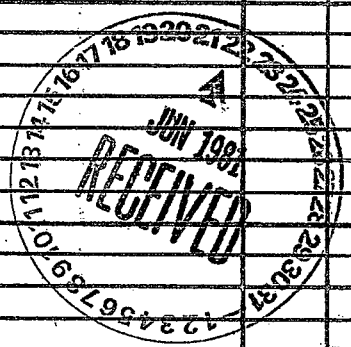

If well telescopes please sketch and show depths.

GROUND LEVEL

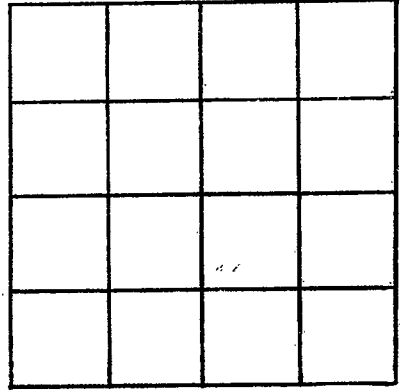

SECTION _____

Please indicate well location X.

ADDITIONAL INFORMATION

If more than one screen, show locations of each on sketch.