

Yalobusha
F 2003

MISSISSIPPI
 BOARD OF WATER COMMISSIONERS
 416 North State Street
 Jackson, Mississippi 39201

WATER WELL DRILLERS LOG

1-29-82 date well completed Austin Cairn Well Service firm name Yalobusha county well located

LANDOWNER: ED Holland
Lake Estate
Oakland Ms Hwy 32 E
 (mailing address)

WELL LOCATION:
 sec. 28 T 25 N R. 5 E
5 miles SE of Oakland
 (distance) (direction) (nearest town)

WELL PURPOSE: Home
 (home, irrigation, municipal, industrial)

WELL COMPLETION DATA:
 (1) diameter (inches) 4
 (2) total depth (feet) 205
 (3) static water level (feet) 80 below top of ground.
 (4) casing PVC, 205,
 (material) (depth)
 (size) if telescope see back.
 (5) screen 10', 195
 (length) (depth to top)
4, PVC
 (size) (material)
 (6) pump 3/4, 10
 (HP) (yield gpm)
Elect
 (type power)
 (7) electric log _____
 (yes or no)

 (organization running log)
 (8) how well bottom plugged. wash Bottom

description of formations encountered	from	to
Clay	0	18
Sand & Clay St	18	65
Blue Clay	65	70
Rock	70	91
Blue Clay	91	180
Sand	180	205

DEPT. OF NATURAL RESOURCES
 BUREAU OF LAND & WATER RESOURCES


MAR - 8 1982

RECEIVED

DRILLERS REMARKS:

If well telescopes please sketch and show depths.

GROUND LEVEL

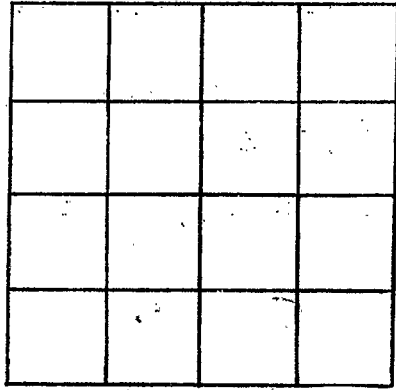

SECTION _____

Please indicate well location X.

ADDITIONAL INFORMATION

Lined area for additional information.

If more than one screen, show locations of each on sketch.