

**MISSISSIPPI  
BOARD OF WATER COMMISSIONERS**  
416 North State Street  
Jackson, Mississippi 39201

**WATER WELL DRILLERS LOG**

date well completed 3/19/84 firm name Lipe/Walk Supply county well located Yalobusha

LANDOWNER: Chris A. Tompkins  
Cassville  
Druid  
(mailing address)

WELL LOCATION:  
sec. 14 T. 25 N. R. 5 E  
5 miles NW of Cassville  
(distance) (direction) (nearest town)

WELL PURPOSE: home  
(home, irrigation, municipal, industrial)

**WELL COMPLETION DATA:**

- (1) diameter (inches) 4"
- (2) total depth (feet) 235
- (3) static water level (feet) 80 below? above?
- (4) casing PVC, 225  
(material) (depth)  
(size) if telescope see back.
- (5) screen 10, 225  
(length) (depth to top)  
4", PVC  
(size) (material)
- (6) pump 2, 25 ?  
(HP) (yield gpm)  
(type power)
- (7) electric log No  
(yes or no)  
(organization running log)
- (8) how well bottom plugged PVC  
cap

description of formations encountered	from	to
<u>top soil</u>	<u>0</u>	<u>10</u>
<u>black clay</u>	<u>10</u>	<u>40</u>
<u>white clay, calc. m.</u>	<u>40</u>	<u>80</u>
<u>blue clay</u>	<u>80</u>	<u>120</u>
<u>clay</u>	<u>120</u>	<u>130</u>
<u>red clay</u>	<u>130</u>	<u>135</u>
<u>blue clay, calc. m.</u>	<u>135</u>	<u>160</u>
<u>red clay</u>	<u>160</u>	<u>235</u>

DEPARTMENT OF NATURAL RESOURCES  
BUREAU OF LAND & WATER RESOURCES


FEB - 6 1984

**RECEIVED**

DRILLERS REMARKS:

If well telescopes please sketch and show depths.

GROUND LEVEL

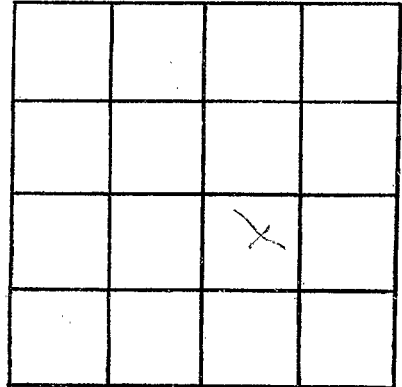

SECTION \_\_\_\_\_

Please indicate well location X.

ADDITIONAL INFORMATION

If more than one screen,  
show locations of each on sketch.