

MISSISSIPPI DEPARTMENT OF NATURAL RESOURCES
Bureau of Land and Water Resources
 Southport Mall
 P.O. Box 10631
 Jackson, Mississippi 39209
WATER WELL DRILLERS LOG

Yalobusha
F 2000

date well completed 10-18 1990 firm name Lipe Well & Supply Co., Inc. county well located Yalobusha

LANDOWNER: Downan Farms
Box 164
Coffeeville, Ms. 38922
 (mailing address)

WELL LOCATION:
 sec. 27 T 25 N R 5 E
2 miles NW of Coffeeville
 (distance) (direction) (nearest town)

| description of formations encountered | from | to |
|---------------------------------------|------|-----|
| Top soil - clay - sand mixed | 0 | 20 |
| clay with sand | 20 | 40 |
| clay with few streaks sand | 40 | 60 |
| clay then sand | 60 | 80 |
| 5' sand - hard clay - d' sand | 80 | 100 |
| sand | 100 | 120 |
| sand - clay with streaks sand | 120 | 140 |
| sand streaks of clay | 140 | 160 |
| sand - streaks of clay | 160 | 180 |
| sand - clay streaks of sand | 180 | 200 |
| clay - streaks of sand | 200 | 220 |
| sand | 220 | 240 |
| sand | 240 | 260 |

WELL PURPOSE: HOME
 (home, irrigation, municipal, industrial)

WELL COMPLETION DATA:

(1) diameter (inches) 6"

(2) total depth (feet) 255

(3) static water level (feet) _____ below above top of ground.

(4) casing PVC, 225
 (material) (depth)
6" if telescope see back.
 (size)

(5) screen 30, 225
 (length) (depth to top)
6", PVC
 (size) (material)

(6) pump 10, 100
 (HP) (yield gpm)
 (type power)

(7) electric log _____
 (yes or no)
 (organization running log)

(8) how well bottom plugged Capped

RECEIVED


APR 16 1991

Dept. of Environmental Quality
 Bureau of Land & Water Resources

DRILLERS REMARKS: _____

If well telescopes please sketch and show depths.

GROUND LEVEL

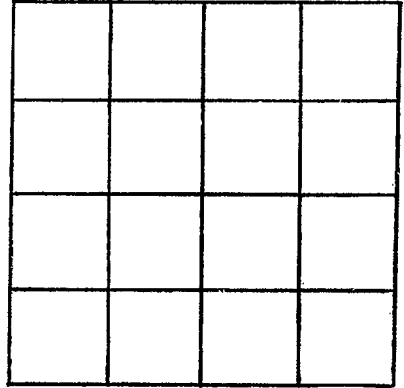

SECTION _____

Please indicate well location X.

ADDITIONAL INFORMATION

If more than one screen,
show locations of each on sketch.