

156

Yalobusha
E 3

12-19-68

MISSISSIPPI
BOARD OF WATER COMMISSIONERS
416 North State Street
Jackson, Mississippi 39201

WATER WELL DRILLERS LOG

Dec 19 1968 Roberson Well Drilling Co Yalobusha
date well completed firm name County well located

LANDOWNER: Assoc. Prestige

description of formations encountered	from	to
Red Clay	0	20
Red Clay + Sand	20	40
White Dry Sand	40	60
White Clay	60	80
White Clay + Sand	80	100
White Sand	100	130

Water Valley Miss
(mailing address)

WELL LOCATION:

sec. 16 T. 25 N. R. 6 E. S. 5 W.
6 miles S of Water Valley
(distance) (direction) (nearest town)

WELL PURPOSE: Home
(home, irrigation, municipal, industrial)

WELL COMPLETION DATA:

- (1) diameter (inches) 4"
- (2) total depth (feet) 130
- (3) static water level (feet) 90 below top of ground.
- (4) casing plastic, 125 (material) (depth)
4" (size) If telescope see back.
- (5) screen 5ft, 125 (length) (depth to top)
4" (size) gravel packed (material)
- (6) pump 3/4, 12 (HP) (yield gpm)
220 (type power)
- (7) electric log Y/N (yes or no)

(organization running log)

(8) how well bottom plugged plugged

DRILLERS REMARKS: plastic water well

DEC 30 1968

MISS. BD. OF
WATER COM. 7

CODED


CODED

CODED

CODED

If well telescopes please sketch and show depths.

GROUND LEVEL

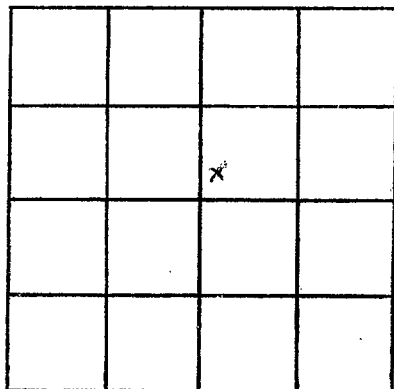

SECTION 16

Please indicate well location X.

ADDITIONAL INFORMATION

If more than one screen,
show locations of each on sketch.