

CODED

CODED

Kalobusha Co.
G-5
2-69

MISSISSIPPI
BOARD OF WATER COMMISSIONERS
416 North State Street
Jackson, Mississippi 39201

WATER WELL DRILLERS LOG

Feb 6 1969 Grant Well Serv Yalobusha
date well completed firm name county well located

LANDOWNER: Charles Cook
PT. ONE
Coffeeville, Miss.
(mailing address)

description of formations encountered	from	to
	<u>Buckshot</u>	<u>1</u>
<u>3rd</u>	<u>18</u>	<u>20</u>
<u>2nd to 2nd mixed</u>	<u>20</u>	<u>30</u>
<u>2nd to 2nd</u>	<u>30</u>	<u>41</u>
<u>Water 3rd</u>	<u>41</u>	<u>48</u>
<u>Good</u>		

WELL LOCATION:
sec 29 T. 25 N. R. 6 E
2 miles N of Coffeeville
(distance) (direction) (nearest town)

WELL PURPOSE: HOUSE TANK
(home, irrigation, municipal, industrial)

- WELL COMPLETION DATA:
- (1) diameter (inches) 2"
 - (2) total depth (feet) 48'
 - (3) static water level (feet) 6 below top of ground.
 - (4) casing Steel, 42 1/2' (depth)
(material) (depth)
if telescope see back.
 - (5) screen 4 1/2', 5 1/2'
(length) (depth to top)
1 1/4", GAUZE
(size) (material)
 - (6) pump 1 Jet, 5
(HP) (yield gpm)
Electric
(type power)
 - (7) electric log NO
(yes or no)

(organization running log)

(8) how well bottom plugged DRIVE
POINT

DRILLERS REMARKS:




MAR 3 1969

MISS. BD. OF
WATER COMM.

If well telescopes please sketch and show depths.

GROUND LEVEL

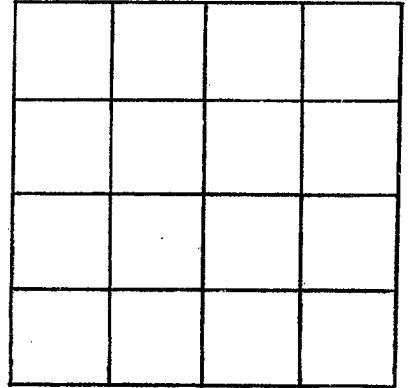

SECTION _____

Please indicate well location X.

ADDITIONAL INFORMATION

If more than one screen, show locations of each on sketch.