

Yalobusha
66
3-3-69

MISSISSIPPI
 BOARD OF WATER COMMISSIONERS
 416 North State Street
 Jackson, Mississippi 39201

WATER WELL DRILLERS LOG

Mar 3 1969 Rabunson Well Drilling Co. Yalobusha
 date well completed firm name county well located

LANDOWNER: Wilfred Cox

description of formations encountered from to

Coffeyville, miss
 (mailing address)

Red Clay 0 20
blue clay 20 60
blue clay & sand 60 80
white 80 100
white sand 100 115-

WELL LOCATION:
 sec 30 T 25 N R 6 E
1/2 miles NW of Coffeyville
 (distance) (direction) (nearest town)

WELL PURPOSE:
 (home, irrigation, municipal, industrial)

WELL COMPLETION DATA:

- (1) diameter (inches) 2"
- (2) total depth (feet) 115-
- (3) static water level (feet) 75- below above top of ground.
- (4) casing plastic 110
 (material) (depth)
4" If telescope see back.
 (size)
- (5) screen 5 ft 110
 (length) (depth to top)
2" gravel packed
 (size) (material)
- (6) pump 1 5-
 (HP) (yield gpm)
220
 (type power)
- (7) electric log no
 (yes or no)
 (organization running log)
- (8) how well bottom plugged capped


MAY 23 1969

MISS. DD. OF
 WATER COMM.

DRILLERS REMARKS: Plastic
Water Well

If well telescopes please sketch and show depths.

GROUND LEVEL

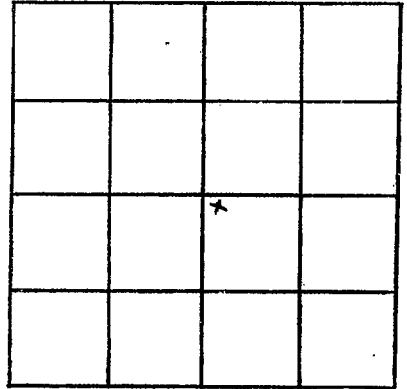

SECTION 30

Please indicate well location X.

ADDITIONAL INFORMATION

If more than one screen,
show locations of each on sketch.