

Yalobusha
G-7
3-22-69

MISSISSIPPI
 BOARD OF WATER COMMISSIONERS
 416 North State Street
 Jackson, Mississippi 39201

WATER WELL DRILLERS LOG

May 22 1969 Roberson Well Drilling Co. Yalobusha
 date well completed firm name county well located

LANDOWNER: Mr. Shaw

description of formations encountered

from to

Coffeesville, Miss
 (mailing address)

<u>Red Clay</u>	<u>0</u>	<u>20</u>
<u>white clay + sand</u>	<u>20</u>	<u>80</u>
<u>Blue Clay</u>	<u>80</u>	<u>160</u>
<u>Blue Clay + sand</u>	<u>160</u>	<u>300</u>

WELL LOCATION:

sec. 24 T 25 N R 6 E
 S W

6 1/2 miles NE of Coffeesville
 (distance) (direction) (nearest town)

WELL PURPOSE: home
 (home, irrigation, municipal, industrial)

WELL COMPLETION DATA:

- (1) diameter (inches) 4"
- (2) total depth (feet) 300
- (3) static water level (feet) 65 below above top of ground.

(4) casing Plastic, 180
 (material) (depth)
4"
 (size) If telescope see back.

(5) screen _____
 (length) (depth to top)

 (size) (material)

(6) pump 1/2 HP 20
 (HP) (yield gpm)
220
 (type power)

(7) electric log yes
 (yes or no)

 (organization running log)


(8) how well bottom plugged open
bottom

DRILLERS REMARKS: Plastic
Water well

MAY 23 1969
 MISS. BD. OF
 WATER COMMISSIONERS

If well telescopes please sketch and show depths.

GROUND LEVEL

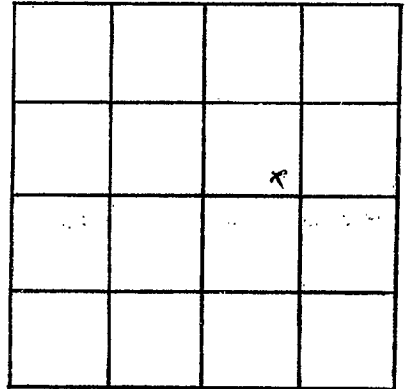

SECTION 24

Please indicate well location X.

ADDITIONAL INFORMATION

If more than one screen,
show locations of each on sketch.