

Yalobusha
68
4-17-69

MISSISSIPPI
 BOARD OF WATER COMMISSIONERS
 416 North State Street
 Jackson, Mississippi 39201

WATER WELL DRILLERS LOG

April 17 1969 Roberson Well Drilling Yalobusha
 date well completed firm name county well located

LANDOWNER: Mr. King

description of formations encountered from to

Coffeyville, Miss
 (mailing address)

<u>Red Clay</u>	<u>0</u>	<u>20</u>
<u>Red Clay & sand</u>	<u>20</u>	<u>60</u>
<u>White Clay & "</u>	<u>60</u>	<u>80</u>
<u>Blue Clay</u>	<u>120</u>	<u>180</u>
<u>Blue Clay & sand</u>	<u>180</u>	<u>320</u>

WELL LOCATION:

sec. 22T 25N R. 6E
6 miles NE of Coffeyville
 (distance) (direction) (nearest town)

WELL PURPOSE: home
 (home, irrigation, municipal, industrial)

WELL COMPLETION DATA:

- (1) diameter (inches) 4"
- (2) total depth (feet) 320
- (3) static water level (feet) 125 -below
 top of ground. 220 above
- (4) casing plastic, 300
 (material) (depth)
4"
 (size) If telescope see back.
- (5) screen _____
 (length) (depth to top)

 (size) (material)
- (6) pump 3/4 12
 (HP) (yield gpm)
220
 (type power)
- (7) electric log no
 (yes or no)

(organization running log)

(8) how well bottom plugged Open
bottom

DRILLERS REMARKS: Plastic


Water Well

MAY 23 1969

MISS. BD. OF
 WATER COMM.

If well telescopes please sketch and show depths.

GROUND LEVEL

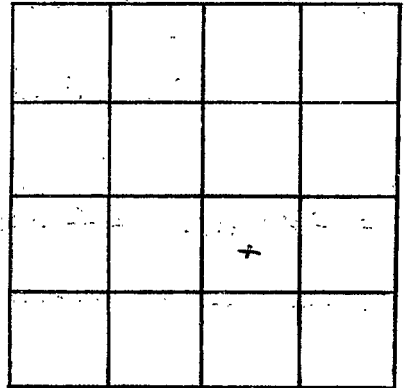

SECTION 22

Please indicate well location X.

ADDITIONAL INFORMATION

If more than one screen,
show locations of each on sketch.