

MISSISSIPPI
BOARD OF WATER COMMISSIONERS
416 North State Street
Jackson, Mississippi 39201 27 1972

WATER WELL DRILLERS LOG

YALOBUSHA
G9
3-22-72

3-22 1972 Sartam Wells Yalobusha
date well completed firm name county well located

LANDOWNER: J.L. Reed
R.T.
Coffeeville, Miss.
(mailing address)

description of formations encountered	from	to
Red clay	1	10
" sand	10	14
White clay	14	16
Red sand	16	20
White sand & clay	20	40
" " "	40	58
" clay	58	60
Blue clay	60	78
sand & "	78	83
White water sand	83	95

WELL LOCATION:
sec. 17 T 25 N R 6 E
S W
4 miles NW of Coffeeville
(distance) (direction) (nearest town)

WELL PURPOSE: Home
(home, irrigation, municipal, industrial)

WELL COMPLETION DATA:

(1) diameter (inches) 2

(2) total depth (feet) 95 1/2

(3) static water level (feet) 60' below above top of ground.

(4) casing Steel, 90' (material) (depth)
2" (size) If telescope see back.

(5) screen 55' 90' (length) (depth to top)
1 1/4" (size) SS. gauze (material)

(6) pump 3/4 (HP) 7 (yield gpm)

(type power)

(7) electric log NO (yes or no)


(organization running log)

(8) how well bottom plugged

DRILLERS REMARKS:

If well telescopes please sketch and show depths.

GROUND LEVEL

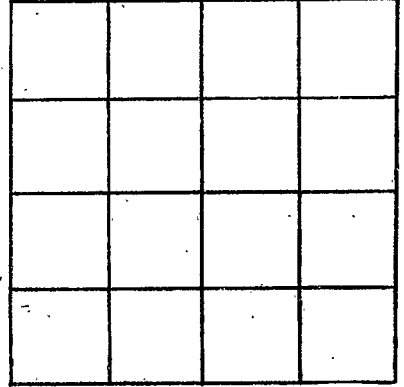

SECTION _____

Please indicate well location X.

ADDITIONAL INFORMATION

If more than one screen,
show locations of each on sketch.