

LEADED  
LEADED

MISSISSIPPI  
BOARD OF WATER COMMISSIONERS  
416 North State Street  
Jackson, Mississippi 39201

WATER WELL DRILLERS LOG

Yalobusha  
G 10  
4-67

4-1 1967 Petersen & Son Yalobusha  
date well completed firm name county well located

LANDOWNER: Clyde Collins  
Coffeesville  
Miss. Rt 1  
(mailing address)


description of formations encountered	from	to
<u>Red clay</u>	<u>0</u>	<u>20</u>
<u>Red sand &amp; clay</u>	<u>20</u>	<u>80</u>
<u>White sand</u>	<u>80</u>	<u>120</u>

WELL LOCATION:  
sec. 28 T. 25 N. R. 6 E  
5 miles N of Coffeesville  
(distance) (direction) (nearest town)

WELL PURPOSE: Home  
(home, irrigation, municipal, industrial)

WELL COMPLETION DATA:

- (1) diameter (inches) 2 in
- (2) total depth (feet) 120
- (3) static water level (feet) 90 below above top of ground.
- (4) casing Plastic, 115  
(material) (depth)  
2 in if telescope see back.  
(size)
- (5) screen 5 ft, 115  
(length) (depth to top)  
3 in, gravel packed  
(size) (material)
- (6) pump 1 HP 6 gal  
(HP) (yield gpm)  
IWA 110  
(type power)
- (7) electric log no  
(yes or no)  
(organization running log)
- (8) how well bottom plugged caped

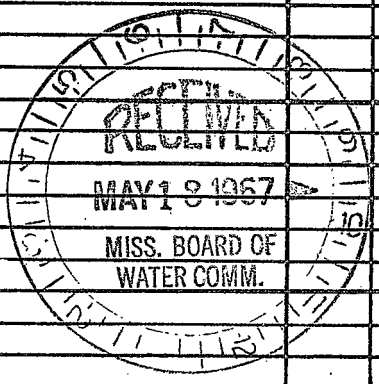

DRILLERS REMARKS: Plastic  
Water Well

If well telescopes please sketch and show depths.

GROUND LEVEL

		X	

SECTION 28

Please indicate well location X.

ADDITIONAL INFORMATION

If more than one screen, show locations of each on sketch.