

CODED
CODED

MISSISSIPPI
BOARD OF WATER COMMISSIONERS
416 North State Street
Jackson, Mississippi 39201

WATER WELL DRILLERS LOG

Yalobusha
G 12
4-67

4-8 1967 Peterson + Son Yalobusha
date well completed firm name county well located


LANDOWNER: Mrs. Dowkins
Rt 1 H.L.
Coffeeville, Miss
(mailing address)
WELL LOCATION:
sec. 30 25 N R. 6 E
4 1/2 miles NE of Coffeeville
(distance) (direction) (nearest town)

description of formations encountered	from	to
	<u>blue clay</u>	<u>0</u>
<u>sand rock</u>	<u>58</u>	<u>61</u>
<u>blue shale</u>	<u>61</u>	<u>190</u>
<u>sand + shale</u>	<u>190</u>	<u>300</u>

WELL PURPOSE: home
(home, irrigation, municipal, industrial)


- WELL COMPLETION DATA:
- (1) diameter (inches) 4 in
 - (2) total depth (feet) 300
 - (3) static water level (feet) 35 below above top of ground.
 - (4) casing Plastic, 200 ft.
(material) (depth)
4 in If telescope see back.
(size)
 - (5) screen open bottom
(length) (depth to top)
(size) (material)
 - (6) pump 1/2 HP. 20
(HP) (yield gpm)
EVA 220
(type power)
 - (7) electric log no
(yes or no)
(organization running log)
 - (8) how well bottom plugged open bottom

DRILLERS REMARKS: Plastic
Water Well

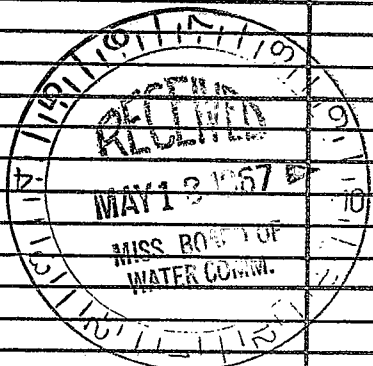

If well telescopes please sketch and show depths.

GROUND LEVEL

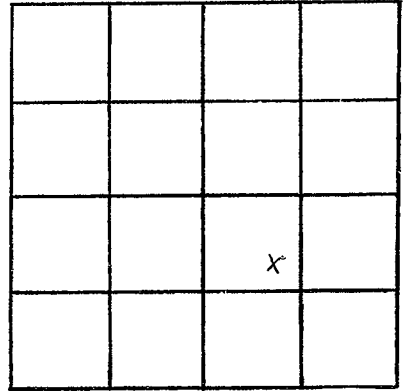

SECTION 35-

Please indicate well location X.

ADDITIONAL INFORMATION

If more than one screen,
show locations of each on sketch.