

YALOBUSHA
 GA
 4-68

MISSISSIPPI
 BOARD OF WATER COMMISSIONERS
 416 North State Street
 Jackson, Mississippi 39201

CODED
 CODED

WATER WELL DRILLERS LOG

April 18 1968 Robertson & Son Yalobuscha
 date well completed firm name county well located

LANDOWNER: M. A. Martin
 Coffeyville, Miss
 (mailing address)
 WELL LOCATION:
 sec. 32 T 25 N 2 R 6 E
 S W
 1/4 miles NW of Coffeyville
 (distance) (direction) (nearest town)

description of formations encountered	from	to
Red Clay	0	20
sand + clay	20	40
white clay + sand	40	60
white sand	60	80

WELL PURPOSE: Domestic
 (home, irrigation, municipal, industrial)


WELL COMPLETION DATA:
 (1) diameter (inches) 2"
 (2) total depth (feet) 80
 (3) static water level (feet) 65 - below above top of ground.
 (4) casing plastic, 75 - (material) (depth)
 2" (size) if telescope see back.
 (5) screen 5 ft, 76 - (length) (depth to top)
 3" (size), gravel packed (material)
 (6) pump 1 (HP) 6 (yield gpm)
 1/2 HP 220 (type power)
 (7) electric log NO (yes or no)
 (organization running log)
 (8) how well bottom plugged plugged

DRILLERS REMARKS: Partic Well

MAY 1 1968
 MISS. BD. OF
 WATER COM.

If well telescopes please sketch and show depths.

GROUND LEVEL

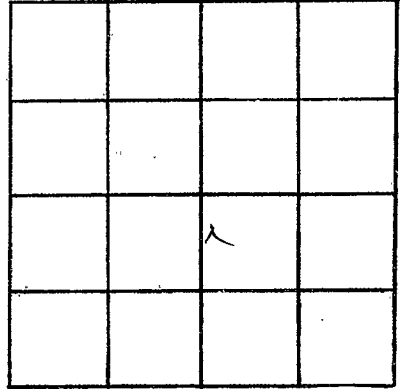

SECTION 32

Please indicate well location X.

ADDITIONAL INFORMATION

If more than one screen,
show locations of each on sketch.