

YALOB.

SSIONERS

OG 7
4-15 62

WATER WELL DRILLERS LOG

J B Cam

Yalobucke

Date: 4-15-62, 19 62, Driller: J B Cam

(Name)

YALOBUCKE COUNTY

4-15-62

HILFORD SHAW

(1) Owner of Land: Hilford Shaw
Coffeyville (Name)

(2) Location: 1 3/4 miles E 36 25 6
(distance) (direction) (Nearest Town)

(3) Topography: Honal (Hilly) (Flat) (Level)

(4) Purpose of Well: (Domestic Irrigation, Municipal, Industrial, Other)

Description & Color of Materials Sand, Clay, Red Clay, Shell, etc.	Thick- ness Feet	Depth Feet
Sand	10	10
	10	63

Information upon completion of well:

(1) Diameter 2" inches.

(2) Total Depth 63 feet.

(3) Water Level 40 feet below top of ground.

(4) Cased to 63 2" Size


(5) Screen: Size 1 1/4 Length 5 FT.

(6) Were any formations sealed against pollution?
yes, no.

If YES depth of formation:

Why:

Drillers Remarks:

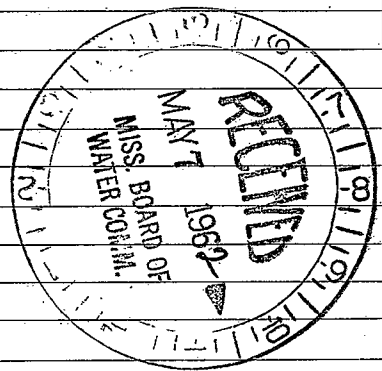

(Use Back Side)

Well No.

1000

1000

