

YALOBUSHA
 20
 4-68

MISSISSIPPI
 BOARD OF WATER COMMISSIONERS
 416 North State Street
 Jackson, Mississippi 39201

CODED
 CODED

WATER WELL DRILLERS LOG

4-15 1968 J.B. Carr Yalobusha
 date well completed firm name county well located

LANDOWNER: JOE KING
WATER VALLEY
MISS
 (mailing address)


description of formations encountered	from	to
Bio of	0	20
Sand	20	40
Blue Sand	40	25
Sand	55	100

WELL LOCATION:
 sec. ~~21~~ N R E
 S W
 10 miles E of Oxford
 (distance) (direction) (nearest town)

WELL PURPOSE:
 (home, irrigation, municipal, industrial)


- WELL COMPLETION DATA:
- (1) diameter (inches) 2"
 - (2) total depth (feet) 100
 - (3) static water level (feet) 55 below above top of ground.
 - (4) casing Plastic, 100,
 (material) (depth)
2"
 (size) if telescope see back.
 - (5) screen 5, 95
 (length) (depth to top)
2, Shank Pack
 (size) (material)
 - (6) pump 1 1/2 10
 (HP) (yield gpm)
Electric
 (type power)
 - (7) electric log no
 (yes or no)
 - (8) how well bottom plugged Plug

DRILLERS REMARKS:

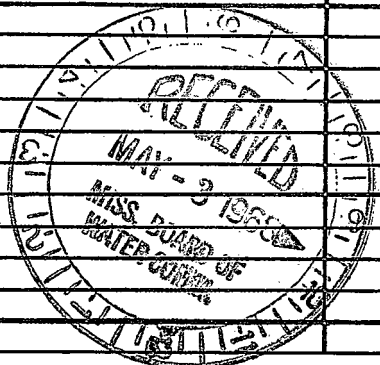

If well telescopes please sketch and show depths.

GROUND LEVEL

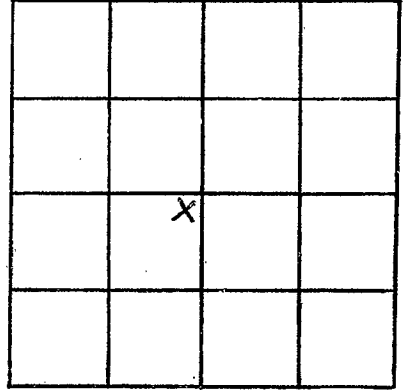

SECTION 8

Please indicate well location X.

ADDITIONAL INFORMATION

If more than one screen, show locations of each on sketch.