

GW 982

33-59-35
89-42-24

Yalobusha
9-18-69
U.S.G.S.

MISSISSIPPI
BOARD OF WATER COMMISSIONERS
G23 416 North State Street
Jackson, Mississippi 39201

G1 is
Test Hole

WATER WELL DRILLERS LOG

SEPT 18 19 67 JAMES PLIPE YALOBUSHA
date well completed firm name county well located

LANDOWNER:

CYPRESS CREEK WA
COFFEEVILLE
(mailing address)

description of formations encountered

from to

DRY HARD SAND 0 115
SAND & CLAY 115 200
WATER SAND 200 44

WELL LOCATION:

sec. 31 T. 25 N R. 10 E
4 miles W of COFFEEVILLE
(distance) (direction) (nearest town)

WELL PURPOSE: F.H.A.
(home, irrigation, municipal, industrial)

WELL COMPLETION DATA:

- (1) diameter (inches) 6
- (2) total depth (feet) 244
- (3) static water level (feet) 140 below top of ground.
- (4) casing Steel, 201, (material) (depth)
4 (size) If telescope see back.
- (5) screen 30, 214 (length) (depth to top)
10, 55 (size) (material)
- (6) pump 7 1/2, 100 (HP) (yield gpm)
- 2 Lec (type power)
- (7) electric log Yes (yes or no) (USGS #35 Test Hole E-log to 795')
- USGS (organization running log)

(8) how well bottom plugged PLUG
STRENGTH

DRILLERS REMARKS:

NO RE

(2)

If well telescopes please sketch and show depths.

GROUND LEVEL




244

6x4 LEADS CABLE
 21'4" PIPE
 30'4" SCREEN

If more than one screen, show locations of each on sketch.

Test Hole

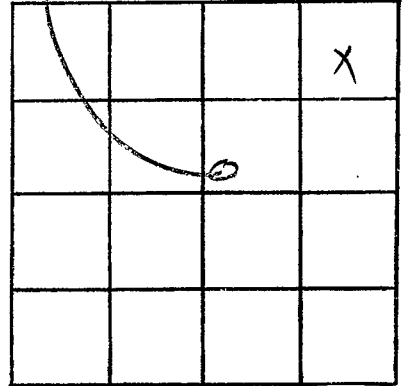

SECTION 31

Please indicate well location X.

ADDITIONAL INFORMATION

Blank lined area for additional information.