

GWI 981 33-59-34

MISSISSIPPI 89-42-24
BOARD OF WATER COMMISSIONERS
416 North State Street
Jackson, Mississippi 39201

CODED

G 24
YALOBUSHA Co.

WATER WELL DRILLERS LOG

Yalobusha

Elog # 52

12/22/72
date well completed

Robert E. Ratliff Co. Inc.
firm name

Yalobusha
county well located


LANDOWNER:	description of formations encountered	from	to
Cypress Creek Water Assoc. Coffersville, Miss. (mailing address)	red clay sand Cavity sand sand & clay sand clay good sand	0 31 42 63 84 126 194 210	31 42 63 84 126 194 210 249 1/2
WELL LOCATION: sec. 31 T 35 N R 5 E 3 miles west of Coffersville (distance) (direction) (nearest town)			
WELL PURPOSE: Industrial (home, irrigation, municipal, industrial)			
WELL COMPLETION DATA:			
(1) diameter (inches) 8"			
(2) total depth (feet) 249 1/2'			
(3) static water level (feet) 116' below top of ground.			
(4) casing 4" steel pipe 210' 5" (material) (depth)			
8" If telescope see back. (size)			
(5) screen 30' (length) 129' 220' (depth to top)			
4" (size) SS (material)			
(6) pump 7.5 (HP) 100 (yield gpm)			
elec. (type power)			
(7) electric log Yes (yes or no) MRS (organization running log)			
(8) how well bottom plugged back pressure better 4"			
DRILLERS REMARKS:			

CODED

FEB 26 1973



If well telescopes please sketch and show depths.

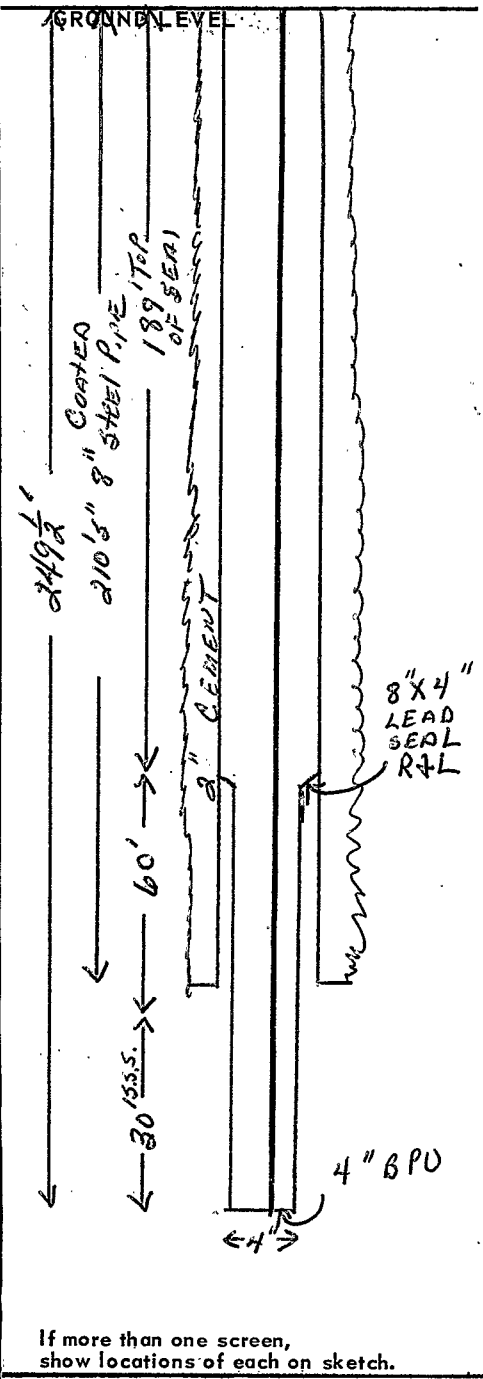

SECTION _____

Please indicate well location X.

ADDITIONAL INFORMATION

If more than one screen, show locations of each on sketch.