

YALOBUSHA
G 25
10-3-72

MISSISSIPPI
 BOARD OF WATER COMMISSIONERS
 416 North State Street
 Jackson, Mississippi 39201

WATER WELL DRILLERS LOG

Oct. 3 1972 Santa Fe Well Supply Yalobusha
 date well completed county well located


LANDOWNER L. Z. Neeley
Coffeeville, Miss.
 (mailing address)

description of formations encountered	from	to
	<u>tan clay</u>	<u>1</u>
<u>Red clay & sand</u>	<u>20</u>	<u>32</u>
<u>fine sand</u>	<u>32</u>	<u>80</u>
<u>White clay</u>	<u>80</u>	<u>82</u>
<u>Water sand</u>	<u>82</u>	<u>98</u>

WELL LOCATION:
 sec. 9 T. 250 S. R. 6E
5 miles N of Coffeeville
 (distance) (direction) (nearest town)

WELL PURPOSE: Home
 (home, irrigation, municipal, industrial)

- WELL COMPLETION DATA:
- (1) diameter (inches) 2
 - (2) total depth (feet) 98
 - (3) static water level (feet) 32 below above top of ground.
 - (4) casing S 93
 (material) (depth)
2" if telescope see back.
 (size)
 - (5) screen 5' 93'
 (length) (depth to top)
1/4 SS G.H. 2e
 (size) (material)
 - (6) pump 1 6 P.M.
 (HP) (yield gpm)
Electric
 (type power)
 - (7) electric log NO
 (yes or no)
- (organization running log)
- (8) how well bottom plugged _____

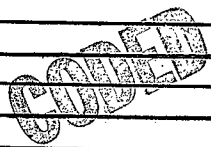


OCT 26 1972

DRILLERS REMARKS: F. H. A
Well
1st & last

MISS. Bd. of
 WATER COMMISSIONERS
 JACKSON, MISSISSIPPI

If well telescopes please sketch and show depths.

GROUND LEVEL

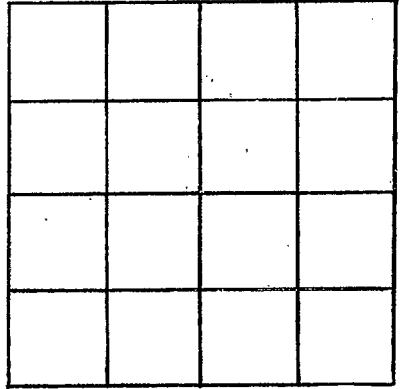

SECTION _____

Please indicate well location X.

ADDITIONAL INFORMATION

than one screen,
locations of each on sketch.