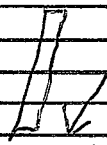


YALOBUSHA
G 27
11-10-72

J. T. Shorten
MISSISSIPPI
BOARD OF WATER COMMISSIONERS
 416 North State Street
 Jackson, Mississippi 39201


WATER WELL DRILLERS LOG **CODED**

Nov 10 19*72* *O. J. Jarrell, Est* *Yalobuska*
 date well completed year name county well located

| LANDOWNER: <i>O. J. Jarrell</i> | description of formations encountered | from | to |
|---|---|---|----|
| <i>Route 1</i> <i>Coffeyville, Miss.</i> (mailing address) | <i>CLAY SAND</i> | | |
| WELL LOCATION: sec. <i>22</i> T. <i>25</i> N. R. <i>6</i> E. W. <i>S</i> <i>4</i> miles <i>N. East</i> of <i>Coffeyville</i> (distance) (direction) of (nearest town) |  <i>BLUE CLAY</i> | <i>0</i> <i>40</i> <i>90</i> <i>95</i> | |
| WELL PURPOSE: <i>None</i> (home, irrigation, municipal, industrial) | | | |
| WELL COMPLETION DATA: (1) diameter (inches) <i>2"</i> (2) total depth (feet) <i>95 ft 5"</i> (3) static water level (feet) <i>18</i> below above top of ground. (4) casing <i>P</i> <i>95 ft 5"</i> (material) (depth) (size) if telescope see back. (5) screen <i>10</i> <i>84'</i> (length) (depth to top) <i>2"</i> <i>P</i> (size) (material) (6) pump <i>1 1/2</i> <i>1 1/2</i> (HP) (yield gpm) <i>T.V.A.</i> (type power) (7) electric log <i>no</i> (yes or no) (organization running log) (8) how well bottom plugged <i>C.A.P.</i> | CODED | | |
| DRILLERS REMARKS: | DEC 4 1972 | | |

If well telescopes please sketch and show depths.

GROUND LEVEL

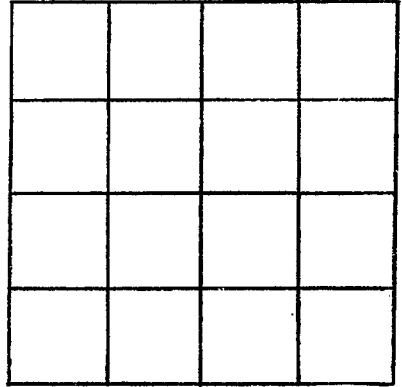

SECTION _____

Please indicate well location X.

ADDITIONAL INFORMATION

If more than one screen, show locations of each on sketch.