

YALOBUSHA
G 28
11-3-72

J. J. Thornton
 MISSISSIPPI
 BOARD OF WATER COMMISSIONERS
 416 North State Street
 Jackson, Mississippi 39201

CODED

WATER WELL DRILLERS LOG

Nov 3 19*72* *J.H. Arrington* *Yalobusha*
 date well completed name county well located

LANDOWNER: *Sam Arrington*
Coffeentle, Miss
 (mailing address)

description of formations encountered	from	to
<i>CLAY-SAND</i>		
	<i>0</i>	<i>5'</i>
	<i>5'</i>	<i>6'</i>
<i>BLUE CLAY</i>		

WELL LOCATION:
 sec *12 T 25 N R 6 E*
5 miles *N. East* of *Coffeentle*
 (distance) (direction) (nearest town)

WELL PURPOSE: *Stock*
 (home, irrigation, municipal, industrial)


- WELL COMPLETION DATA:
- (1) diameter (inches) *2"*
 - (2) total depth (feet) *60*
 - (3) static water level (feet) *23* below top of ground
 - (4) casing *P* *60*
 (material) (depth)
 (size) if telescope see back.
 - (5) screen *10'* *50'*
 (length) (depth to top)
2" *P*
 (size) (material)
 - (6) pump *1 H.P.* *5*
 (HP) (yield gpm)
T.V.A.
 (type power)
 - (7) electric log *no*
 (yes or no)
 - (organization running log)
 - (8) how well bottom plugged *C.A.P.*

CODED

DEC 4 1972


DRILLERS REMARKS:

MIS. ...
 WATER C...

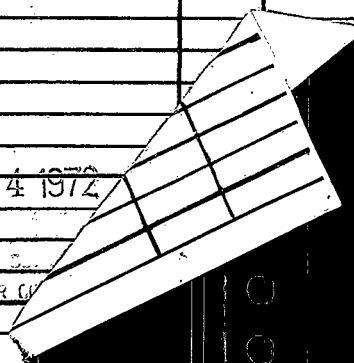

If well telescopes please sketch and show depths.

GROUND LEVEL

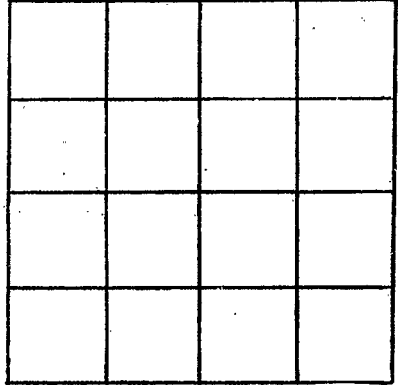

SECTION _____

Please indicate well location X.

ADDITIONAL INFORMATION

Lined area for additional information, consisting of approximately 20 horizontal lines.

one screen,
s of each on sketch.