

YALOBUSHA  
G 29  
5-17-73

MISSISSIPPI  
BOARD OF WATER COMMISSIONERS  
416 North State Street  
Jackson, Mississippi 39201

**CODED**

WATER WELL DRILLERS LOG

5-17 1973 date well completed  
S.H. Tain Well Supply firm name  
Yalobusha county well located

LANDOWNER: LeRoy Admond

description of formations encountered	from	to
---------------------------------------	------	----

CoFFeeville, Miss.  
(mailing address)

Top clay	1	6
White Pipe clay	6	22
Fine White Sand	22	32
Course yellow "	32	62
" White "	62	73

WELL LOCATION:  
sec. 29 T. 25 N R. 6 E  
S W  
2 miles N of CoFFeeville  
(distance) (direction) (nearest town)

WELL PURPOSE: HOME  
(home, irrigation, municipal, industrial)

WELL COMPLETION DATA:

- (1) diameter (inches) 2
- (2) total depth (feet) 73
- (3) static water level (feet) 10 below above top of ground.
- (4) casing 5 68  
(material) (depth)  
2 If telescope see back.  
(size)
- (5) screen 5 68  
(length) (depth to top)  
1/4 SS. BANZ  
(size) (material)
- (6) pump 1 7  
(HP) (yield gpm)  
  
(type power)
- (7) electric log NO  
(yes or no)  
  
(organization running log)
- (8) how well bottom plugged \_\_\_\_\_


**CODED**

MAY 23 1973

DRILLERS REMARKS:

If well telescopes please sketch and show depths.

GROUND LEVEL

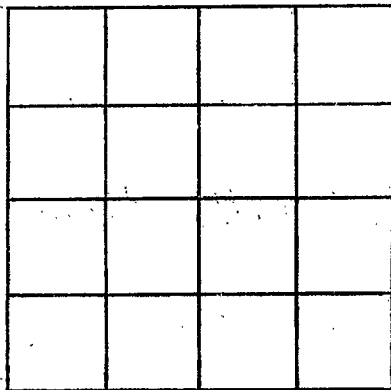

SECTION \_\_\_\_\_

Please indicate well location X.

ADDITIONAL INFORMATION

If more than one screen,  
show locations of each on sketch.