

YALOBUSHA
G 30
5-18-73

MISSISSIPPI
BOARD OF WATER COMMISSIONERS
416 North State Street
Jackson, Mississippi 39201

CODED

WATER WELL DRILLERS LOG

6-18-73 date well completed 1973 James R. Lipe firm name Yalobusha county well located

LANDOWNER: Hugh Fulwood
Coffeeville Miss.
(mailing address)

description of formations encountered
Red sand
white clay
white sand

from	to
0	20
20	40
40	60
60	80
80	150

WELL LOCATION:
sec. 17 T-25 (N) R-6 (E)
S W
4 miles N.W. of Coffeeville
(distance) (direction) (nearest town)

WELL PURPOSE: Home
(home, irrigation, municipal, industrial)

- WELL COMPLETION DATA:
- (1) diameter (inches) 4
 - (2) total depth (feet) 150
 - (3) static water level (feet) 90 below top of ground.
 - (4) casing PVC 140 (material) (depth)
4 (size) if telescope see back.
 - (5) screen 10 140 (length) (depth to top)
4 PVC (size) (material)
 - (6) pump 3/4 10 (HP) (yield gpm)
Elec. (type power)
 - (7) electric log NO (yes or no)
NO (organization running log)
 - (8) how well bottom plugged PVC PLUG

CODED


JUN 7 1973

DRILLERS REMARKS:

MISS. BD. OF
WATER COMMISSIONERS

If well telescopes please sketch and show depths.

GROUND LEVEL

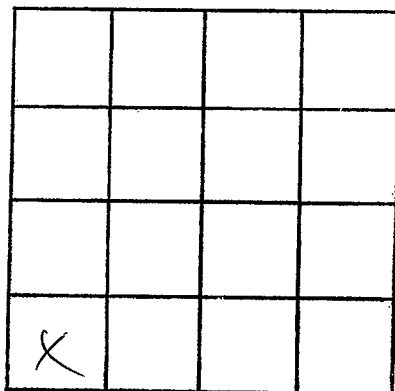

SECTION 17

Please indicate well location X.

ADDITIONAL INFORMATION

If more than one screen,
show locations of each on sketch.