

YALOBUSHA

631

8-17-73

MISSISSIPPI
 BOARD OF WATER COMMISSIONERS
 416 North State Street
 Jackson, Mississippi 39201

CODE

WATER WELL DRILLERS LOG

8-17

date well completed

James R. Lipe

firm name

Yalobusha

county well located

LANDOWNER:

J. G. Harper

Water valley Miss,

(mailing address)

description of formations encountered

TOP soil

sand

Clay

sand and clay

sand

from

to

0 20

20 40

40 60

60 80

80 100

100 131

WELL LOCATION:

sec. 10 T 25 N R 6 E

8 miles West of Water valley

(distance) (direction) (nearest town)

WELL PURPOSE:

(home) Irrigation, municipal, industrial

WELL COMPLETION DATA:

- (1) diameter (inches) 4
- (2) total depth (feet) 131
- (3) static water level (feet) 90 below above top of ground.
- (4) casing PVC, 121' (material) (depth)
4" (size) if telescope see back.
- (5) screen 10' 121' (length) (depth to top)
4" (size) PVC (material)
- (6) pump 3/4 HP 10 (yield gpm)
elec. (type power)
- (7) electric log NO (yes or no)
NO (organization running log)
- (8) how well bottom plugged PVC plug


CODED

DRILLERS REMARKS:

SEP 6 1973

If well telescopes please sketch and show depths.

GROUND LEVEL

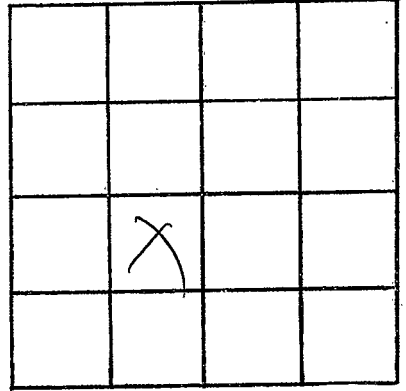

SECTION 10

Please indicate well location X.

ADDITIONAL INFORMATION

If more than one screen,
show locations of each on sketch.